

Drawing Index

- Page 1) Title Page/Site Plan

2) Roof Plan /Scope of Work

3A) Existing Floor / Demolition Plan

3B) Existing Elevations

4) Proposed Floor Plan/window Schedule
Main Floor

5) Proposed Floor Plan
Basement Game Room / JADU conversion

6) Exterior Elevations

7) Landscape and Tree Removal

8) Survey / Topographic

9) Storm Water Control / Storm drainage Impervious Surface/Tenant Parking

10) Excavation and Grading Plan

* 558 Canyon Rd Property Description

Apn# 057-20-115

Zone Code RH/DR Residential Hillside/Design Review

Lot Size 66,990 square feet.

Zone Type Single Family Residence

Wood Frame Construction 2 story with basement	
Existing Living	1770 \$
Existing Basement	602 \$
Proposed JADU	483 \$
Proposed Addition	224 \$
Proposed Redwood Deck	128 \$
Second Covered Patio	745 \$

Proposed Front Entry Platform 567 P

% of New Floor area to Existing

Living Area to lot # cover

Living Area Main Unit
Existing + Basement + Addition
 $(1772 + 107) = 1879 \div 11,880 \times 100 = 3.9\%$

Living Area 5 A.D.A

$$\text{Combined: } \frac{(483)}{66,990} \times 100 = 7.2\%$$

$$(2546 + 483) \div 6$$

$$1770 + 224 + 765 + 532 + 452 \text{ (Eves)} \div 6,990 \times 100\% = 5.59\%$$


$$\% \text{ of Impervious Area} = 9421 \div 66,990 \times 100 = 14.1\%$$

% of New Added Floor area to Existing Floor area

$$(483 + 224)$$

Lección 56 - Paseo M

Excel# 057-20-111

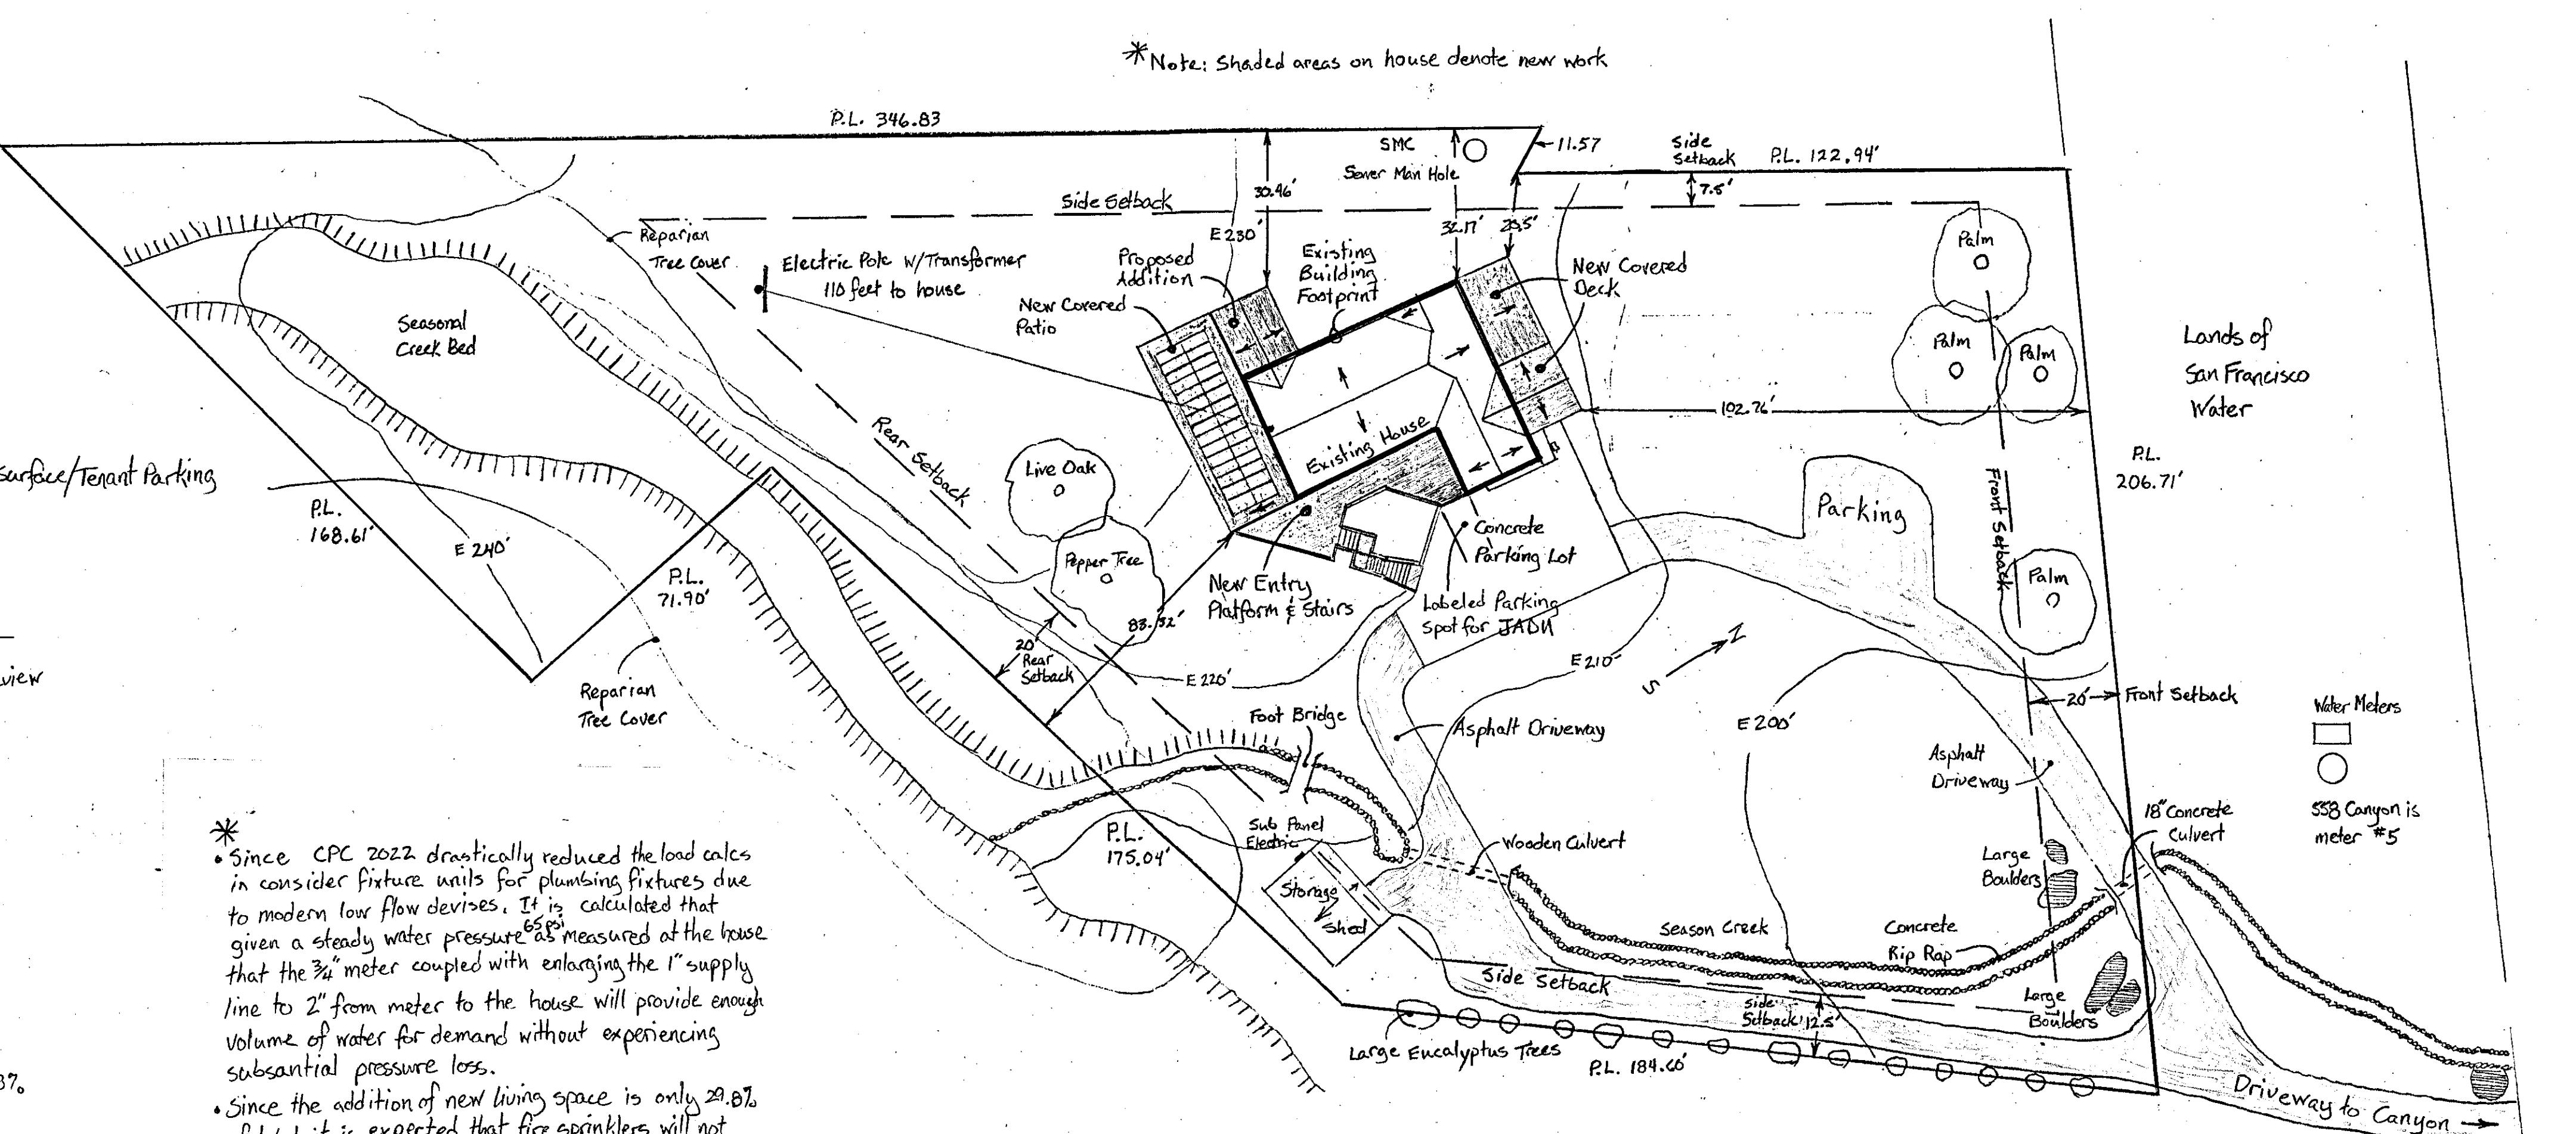

HERS Features Summary

Building Level Verifications	None
HVAC Heat Pump Verifications	
verified heating Cap47	
" " Cap17	
verified cooling EER	
" " SEER	
HVAC Duct Systems.	N/A
Domestic Hot Water system	None
HVAC Fan system Verification	N/A

558 Canyon Rd. Project Description

55B Canyon Rd. is a ranch style two story of 1750 square feet with a 651 square foot basement living area and a 423 square foot Basement garage. It was built in 1961 when structural and energy codes weren't very stringent. Since this property is meant to be our forever home and extended family compound we need to bring everything up to 21st century standards. The work to be done from these plans has been broken down into sections:

Section A is about adding 224 additional square feet to bedroom #2 to turn it into a master suite. The old master bedroom is small and its bathroom is even smaller.

Section B is removing the old rock rubble retaining wall and pouring a new structural retaining wall able to support a roof load, pouring a new 6" patio slab and constructing a new patio roof capable of carrying the load from a 28 panel solar photovoltaic system. The patio conveniently faces south for optimal exposure to the sun all day.

Section C has us removing the old entry stairs because much of the wood structure that supported them had turned to dust because of termites and rot. The concrete steps didn't have any metal reinforcement so sections were beginning to collapse. The old stairs were too steep as I had personally tripped on them many times. Moving the stairs and constructing a new entry platform allowed for a more gradual rise up and a less cramped feel at the entry way. The platforms are to be sloped and waterproofed to shed water.

Section D will replace rotted secondary deck with a new structure able to carry a second story roof load, no more rot. Part of the deck will have a shed roof and part will be more enclosed with a gable roof to be more esthetically pleasing to look at. The gabled part of the deck will be insulated as it might be closed in as living space connecting to Section G in future development.

Section E sees to the renovation of the existing house. The old and badly cracked stucco will be removed to apply insulation, seismic sheathing and energy efficient windows so a new stucco system can be applied. The floor in the sunken living room will be raised to the same level as the rest of the house to save old folk from probable injuries from falling. Convert an extra closet from the old master bedroom into a powder room and replace everything in the old master bathroom to repair a rotted out floor from a shower leak. Remove stairs going down into basement garage and close in the hole in the floor to add more space to the kitchen and also add a laundry closet at that location. Remodel the kitchen with new cabinets and countertops keeping the major appliances and sink in their existing locations. Upgrade the main panel from 200 to 400 amps that will serve five sub panels. Remove brick wall against fireplace to add two windows on either side. Replace all finishes for a new modern look.

Section F sees the replacement of the very cracked and pushed up basement/garage slab, due to root infiltration, with a new 6" slab replete with 2 story footings and putting the existing walls back into place. The garage door is to be replaced with a wall bearing seismic sheathing to make up for a very weak point in the structure. The garage will be converted into a TADU.

Date 5/5/2023
Scale 1mm = 1 foot
Drawn CSt
Job 558 Canyon Rd
Sheet 1
of 10 Sheets

Site Plan

APN 152 28 115

N45° 05'E


346.83'

Property Line

Scope of Work:

- 1) Extend bedroom to make a master suite.
- 2) Form and pour new concrete perimeter foundation.
- 3) Stick frame, subfloor, walls and roof structure then sheath per code.
- 4) Apply composition roof and gutters.
- 5) Frame new partition walls in existing bedroom space for walk in closet, bathroom and heat bedroom access.
- 6) Install rough plumbing per code.
- 7) Install rough electrical per code.
- 8) Insulate walls and ceilings per code.
- 9) Hang sheet rock per code. Tape, bed and paint.
- 10) Install wire and lather per code, apply stucco.
- 11) Hang cabinets and set counter tops.
- 12) Lay prefinished floor, set doors, apply wood casings on doors, floors and windows.
- 13) Install finish plumbing and electrical.
- 14) Touch up paint.


- Section B -** Redo concrete patio and wall and top with wood frame roof structure to support solar panels.
- 1) Take down rock and concrete cobble wall.
 - 2) Dig footings for retaining wall and roof support. Form and pour concrete retaining walls per code.
 - 3) Frame roof structure and sheath per code.
 - 4) Form and pour new concrete patio slab.
 - 5) Apply torch down roof, install gutter.
 - 6) Run new electrical switch leg for can lights.
 - 7) Hang sheet rock for ceiling. Tape, bed and paint.
 - 8) Install wood trim and touch up paint.
 - 9) Install drain for exterior retaining wall and backfill.
 - 10) Install solar system on the roof per code.

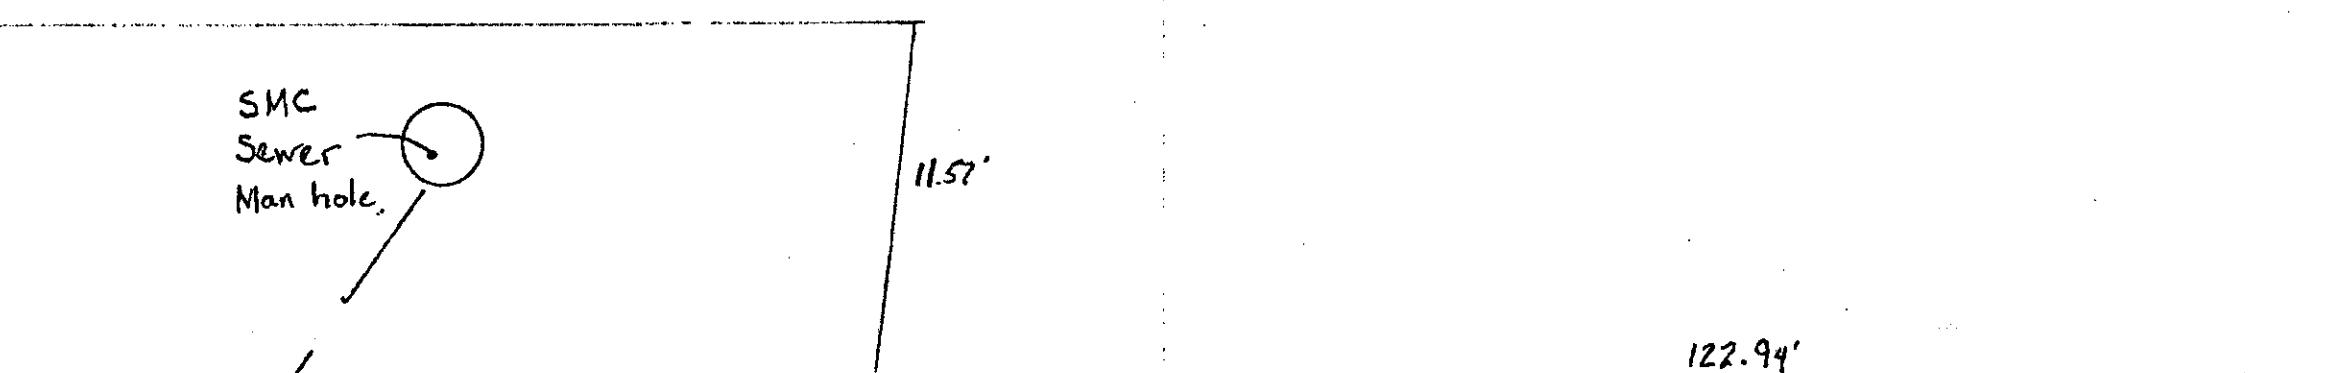

Section D - Reconstruction of second floor deck and adding roof structure.

- 1) Remove rotten old deck and first floor pavers.
- 2) Dig footings, form and pour concrete for slab and foundation for second floor deck structure w/roof. Per code.
- 3) Frame walls, floor structure and roof structure and sheath per code.
- 4) Apply roofing materials; torch down for flat roof, residential comp. for sloped roof. Install gutters.
- 5) Install rough electrical (plugs, switches & can lights).
- 6) Insulate walls and ceiling in cable part of deck per code.
- 7) Install sheet rock, apply tape and bed and paint per code.
- 8) Lay porcelain pavers and trim.
- 9) Apply wood trim and handrails and paint.
- 10) Install finish electrical.

* Fire Note: Roof assemblies in the Fire Hazard Severity Zones shall be Class A rated when tested in accordance with ASTM E108 or UGL 790.

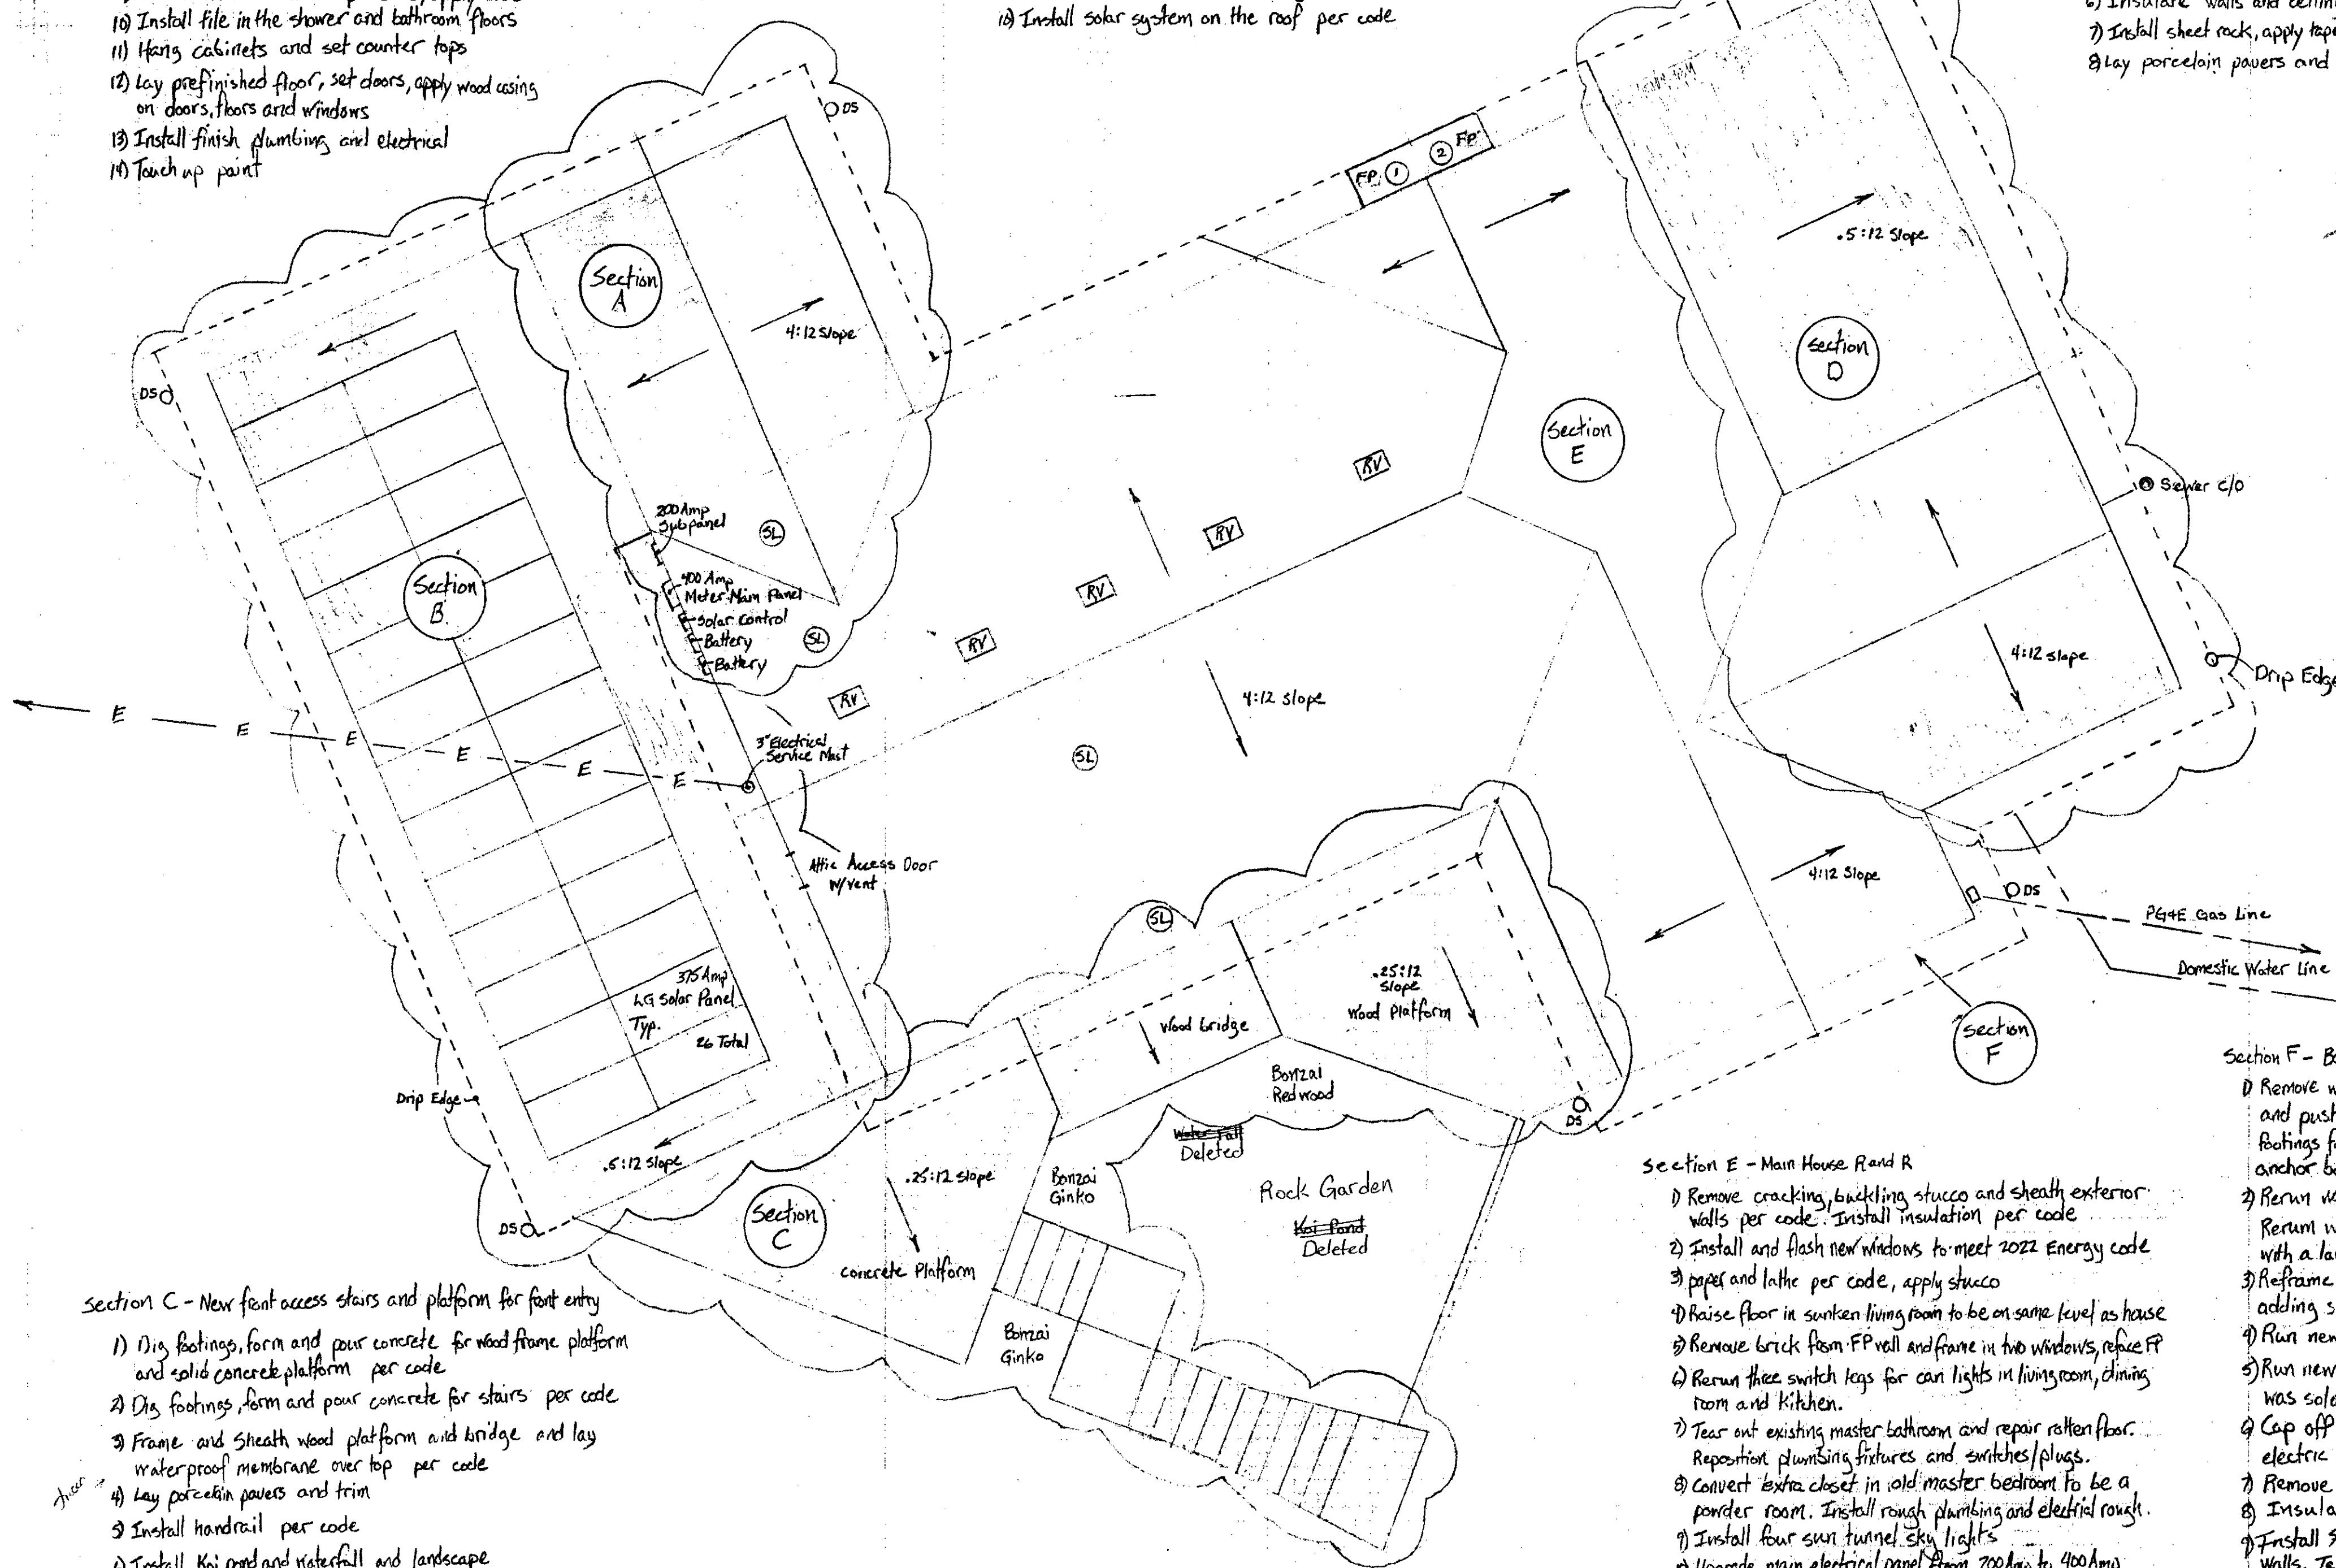

- Section C -** New front access stairs and platform for front entry
- 1) Dig footings, form and pour concrete for wood frame platform and solid concrete platform per code.
 - 2) Dig footings, form and pour concrete for stairs per code.
 - 3) Frame and sheath wood platform and bridge and lay waterproof membrane over top per code.
 - 4) Lay porcelain pavers and trim.
 - 5) Install handrail per code.
 - 6) Install Koi pond and waterfall and landscape.

Section E - Main House Rand R

- 1) Remove cracking, buckling stucco and sheath exterior walls per code. Install insulation per code.
- 2) Install and flash new windows to meet 2022 Energy code paper and lather per code, apply stucco.
- 3) Raise floor in sunken living room to be on same level as house.
- 4) Remove brick from FP well and frame in two windows, replace FP.
- 5) Relocate three switch legs for can lights in living room, dining room and kitchen.
- 6) Tear out existing master bathroom and repair rotten floor. Reposition plumbing fixtures and switches/plugs.
- 7) Convert extra closet in old master bedroom to be a powder room. Install rough plumbing and electrical rough.
- 8) Install four sun tunnel sky lights.
- 9) Upgrade main electrical panel from 200Amp to 400Amp.
- 10) Remove sheet rock on inside living room wall to apply plywood nailed on pattern for seismic support and then re sheet rock.
- 11) Close off stairs down to garage, framed support and set subfloor.
- 12) Plumb for washer and electric for dryer w/vent.
- 13) Move refrigerator and stove to exterior wall.
- 14) New Kitchen cabinets, counter tops, electrical and plumbing to stay in place.
- 15) New floors, doors and casings throughout.
- 16) New roof with R21 reflective barrier under shingles on living areas.
- 17) New minisplit heatpump systems throughout house.

- (1) New Work
- (2) New or Replacement Impervious Surface
 - - - Drip Edge
 - - - Sewer Line
 - - - Overhead Electrical Service
 - - - Domestic Water Line
 - - - PGAE Gas Line
- (3) ODS - Down Spout
- (4) SL - Sky Light
- (5) RV - Roof Vent
- (6) FP - Fire Place

Section F - Basement and garage conversion to JADU

- 1) Remove walls and concrete slab, oak tree roots had broken and pushed up concrete by almost three inches. Dig footings for brace walls and across garage face, add anchor bolts. Form and pour.
- 2) Relocate lines for Kitchen, carreid through at points. Relocate waste lines added down stairs bathroom along with a large section of the main 4" x 4" waste line.
- 3) Reframe downstairs basement and garage walls adding sheathing for brace walls.
- 4) Run new rough electrical and plumbing in walls.
- 5) Run new enlarged copper water system, old system was soldered with 50/50 lead.
- 6) Cap off gas lines for WH and Furnace. Install new electric heat pump WHs and minisplit heat/air system.
- 7) Remove all old HVAC ducting.
- 8) Insulate per code.
- 9) Install 5/8 type X rock on the lid and soffits, 1/2" on all walls. Tape, bed and paint.
- 10) Leave the basement portion of the garage for storage and finish the garage as a JADU.
- 11) Tile Shower and bathroom floor, engineered flooring everywhere else.
- 12) Install cabinets, doors and casings.
- 13) Install finish electrical and plumbing.
- 14) Set up efficiency kitchen.

REVISIONS	BY

558 Canyon Rd, Emerald Hills 94062


Owners: David and Ha Saunders
23200 Mora Glen Dr. Los Altos Hills Ca. 94022

Contractor: Calvin Linoero 408-568-5002/squash1988@gmail.com


Date	5/5/2023
Scale	1/16 = 1 foot
Drawn	CAL
Job	558 Canyon Rd.
Sheet	2
of 10	Sheets

Existing Structure/Demolition

Upper Main Floor

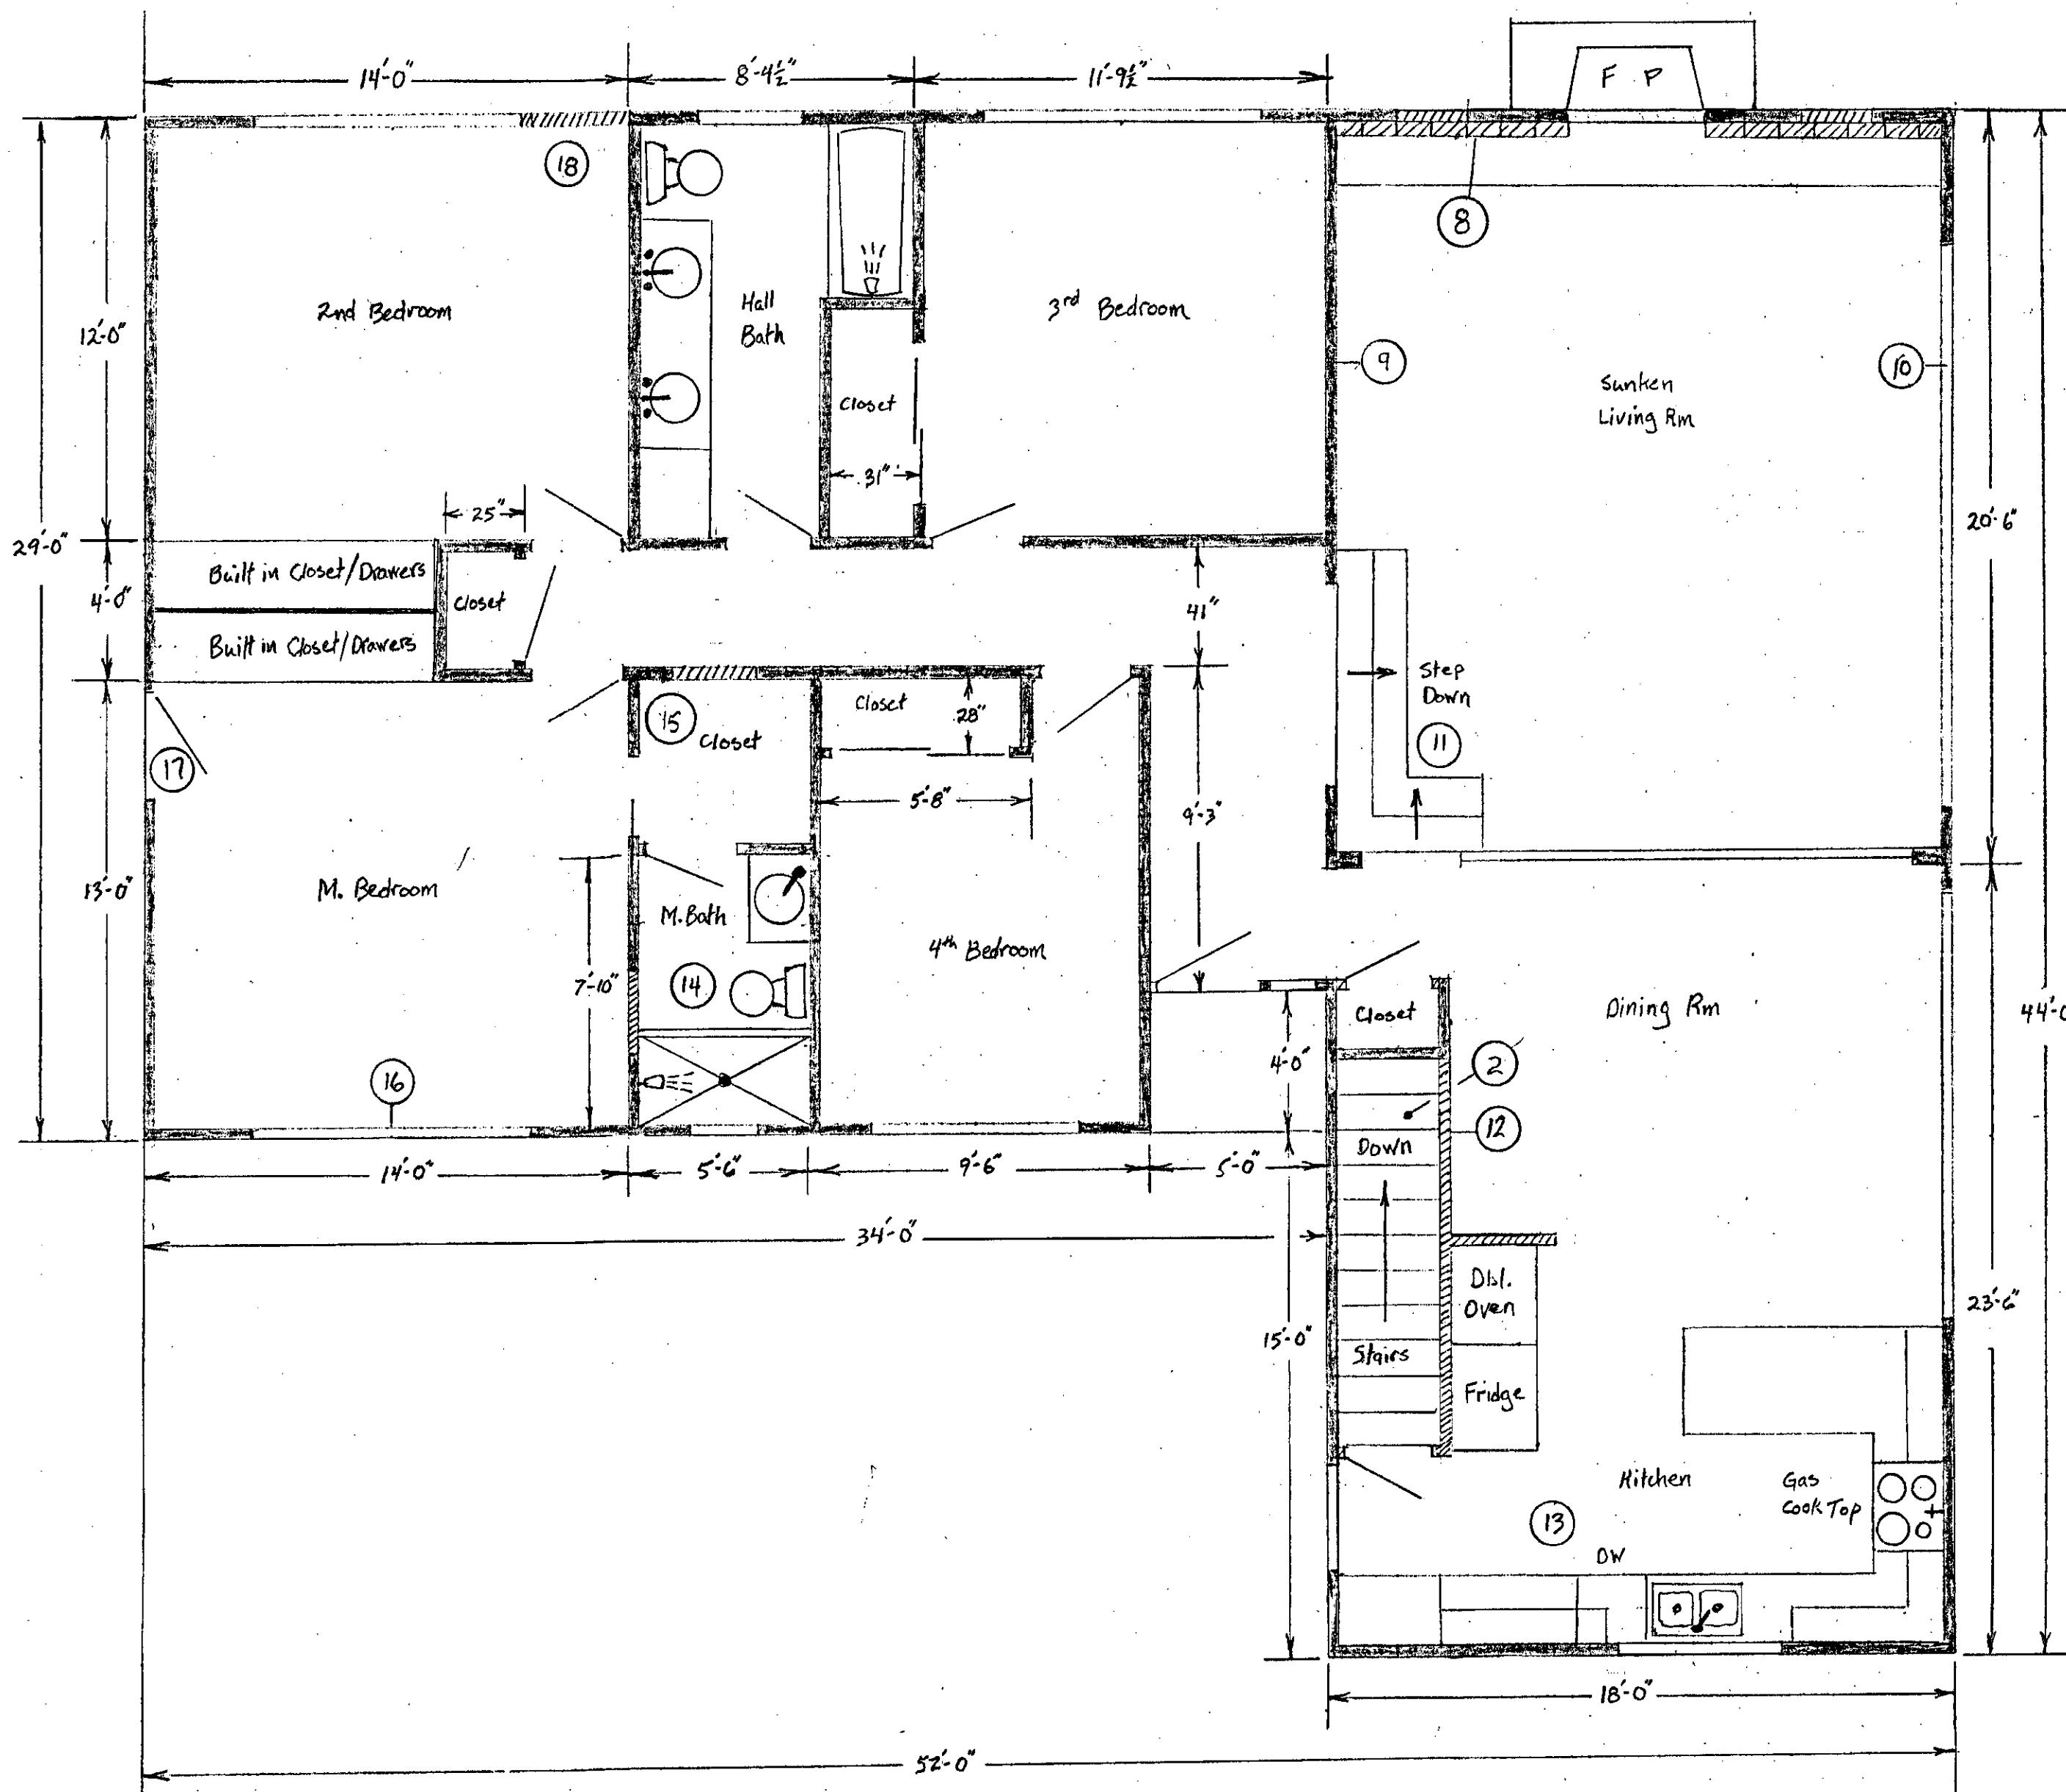

Lower Basement/Garage Floor

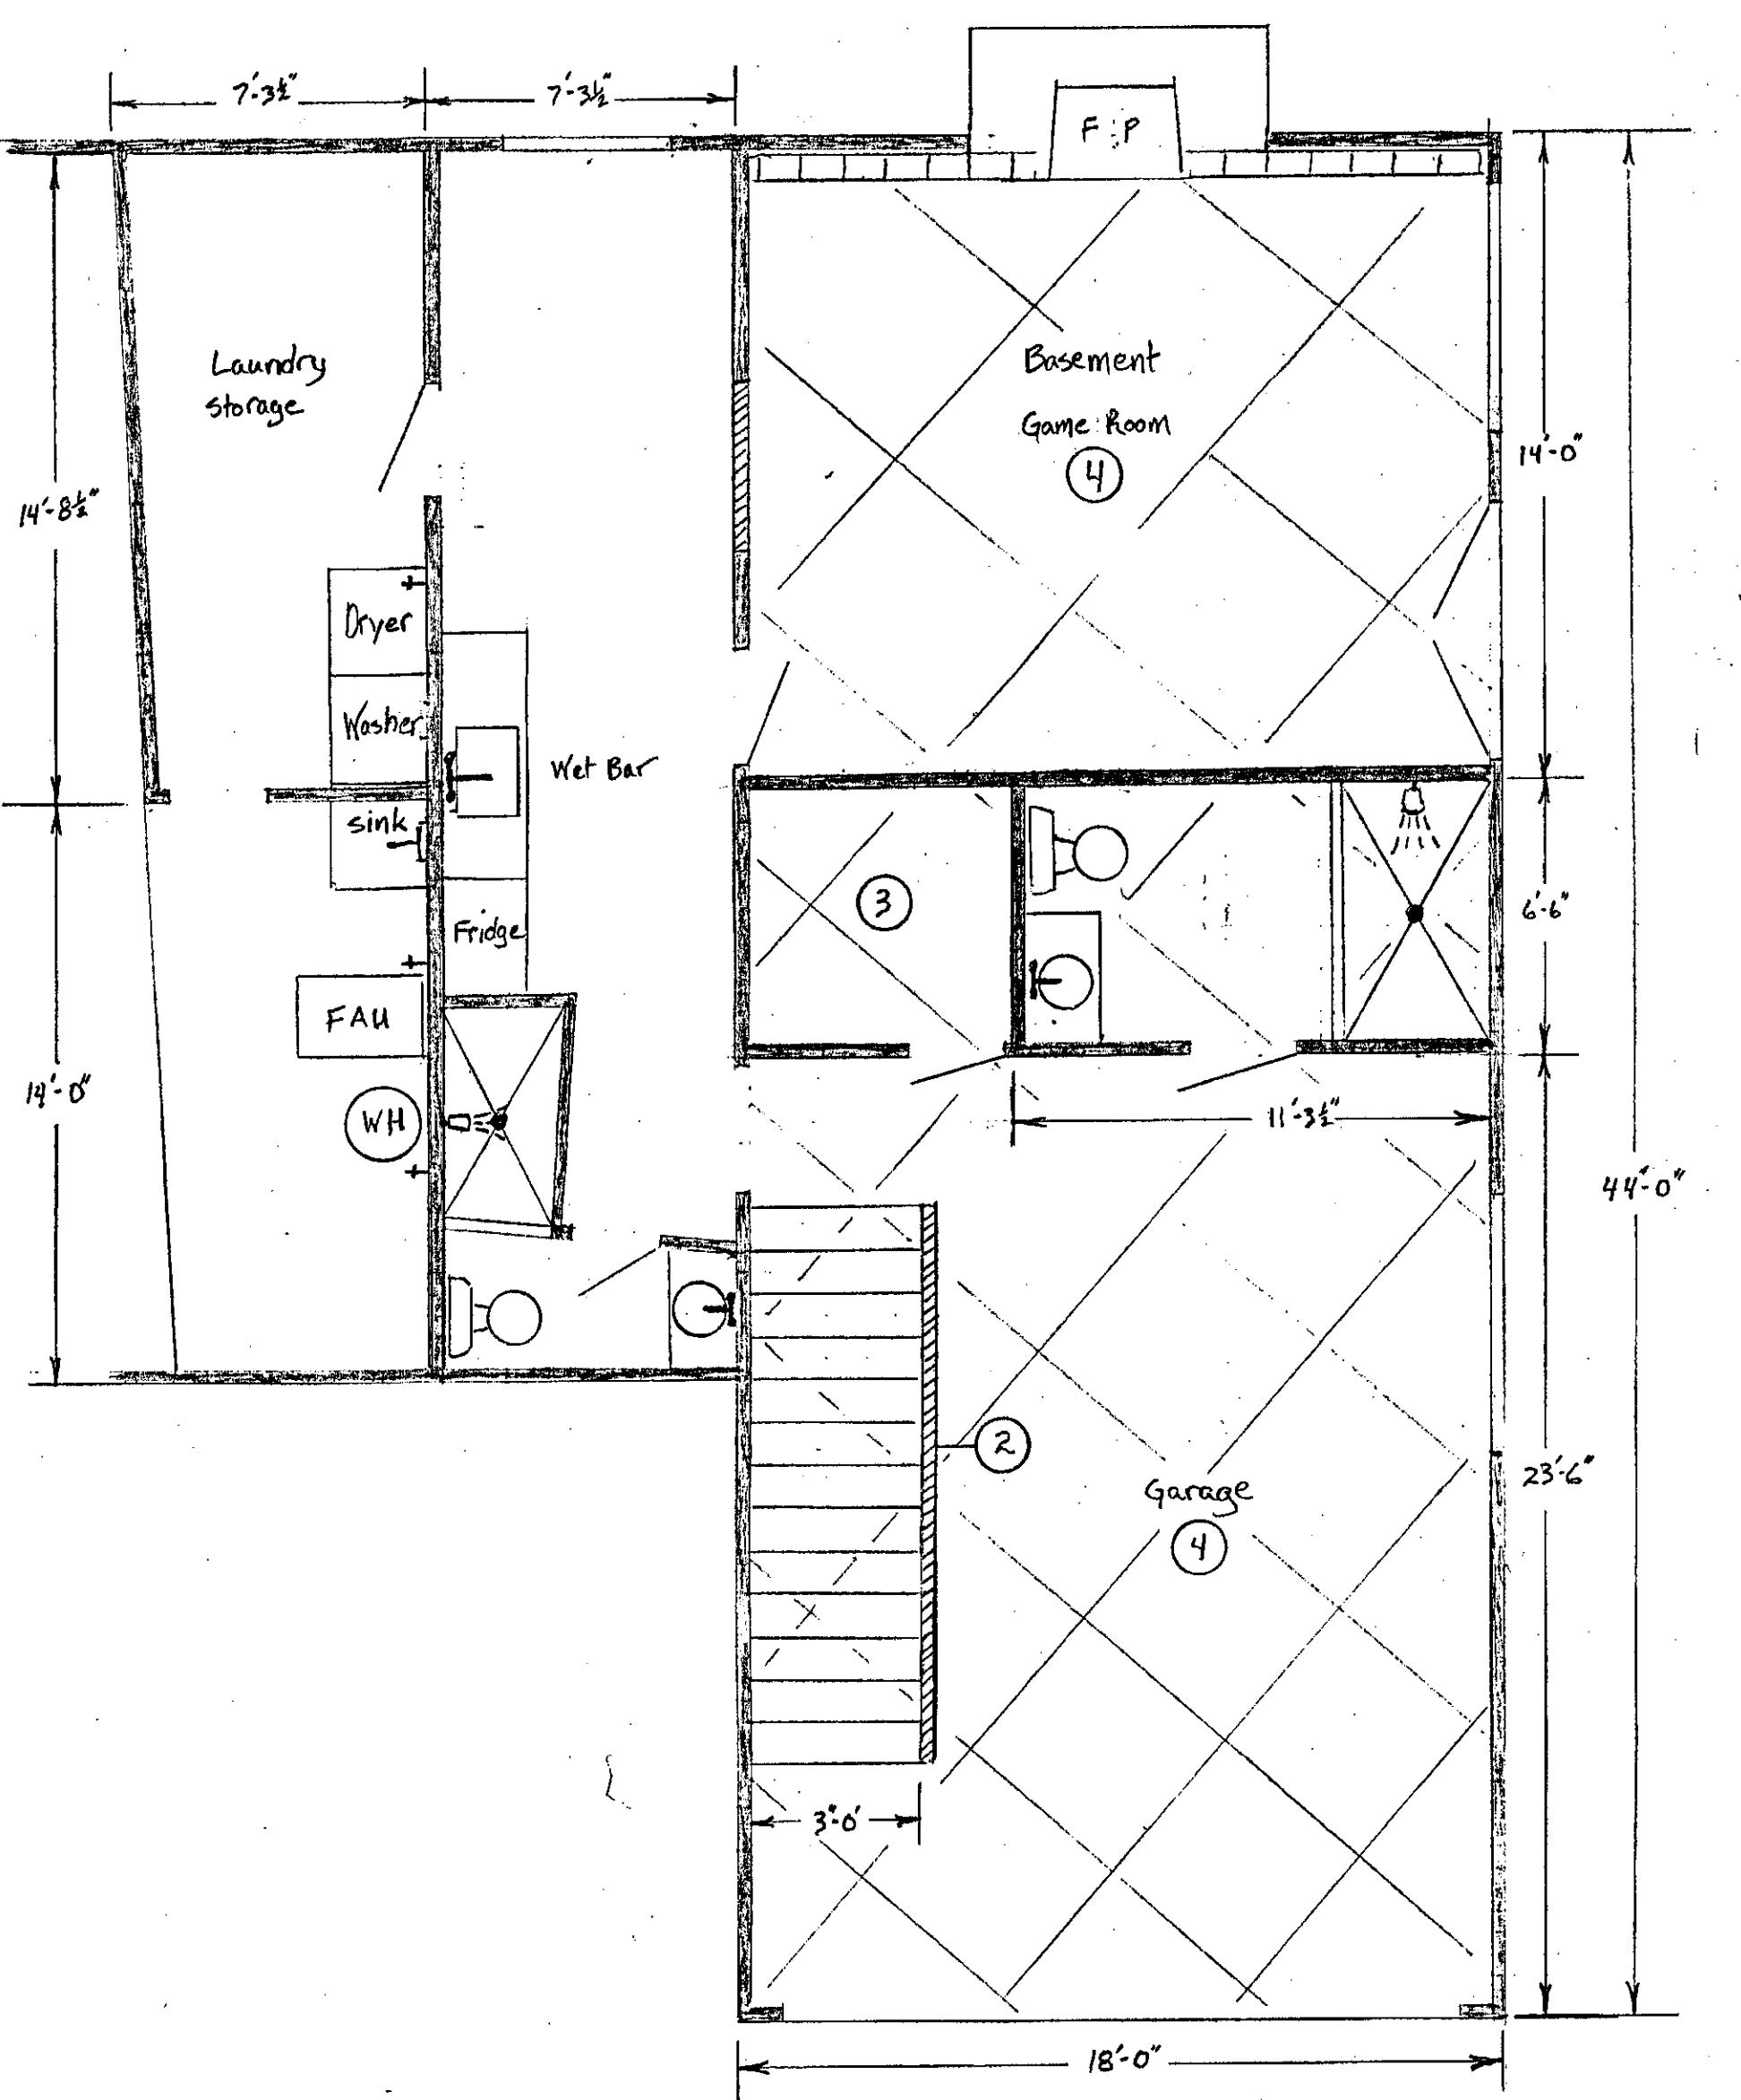

Demolition Notes:

- 1) Remove all plumbing fixtures, tile in the shower and cap off or plug all open plumbing lines in basement/garage
- 2) Remove stairs
- 3) Remove walls // in basement
- 4) Remove concrete slab as marked X in basement
- 5) Remove all sheet rock in basement/garage
- 6) cap off unnecessary gas lines.
- 7) Remove WH and FAU/duct work
- 8) Remove bricks on FP wall and hearth,
- 9) Remove sheetrock on wall
- 10) Remove and store sliding door
- 11) Remove steps and railing
- 12) Remove appliances, sheet rock and wall
- 13) Remove appliances and cabinets
- 14) Strip bathroom of plumbing and sheetrock, remove rotten floor boards, open wall for new door location
- 15) Remove sheet rock, open wall for new door location
- 16) Remove window and prep space for slider
- 17) Remove door to fill space
- 18) Remove sheetrock in bedroom where needed, open wall where mark for access to bedroom addition
- 19) Remove stucco from walls side by side, don't start next side before bare wall can be insulated and sheathed to retain structural rigidity.
- 20) Replace all windows to meet 2022 energy code

REVISIONS	BY





558 Canyon Rd, Emerald Hills 94062
Owner: David and Ha Saunders
23200 Marca Glen Dr, Los Altos Hills 94022
Contact: Colvin Lavers 408-268-5002 / colvnel1978@gmail.com

Date 5/5/2023
Scale $\frac{1}{4}$ = 1 foot
Drawn CSL
Job 558 Canyon Rd.
Sheet 3
Of 6 Sheets

REVISIONS	BY

Old Elevations


scale $\frac{3}{16}$ " = 1 foot

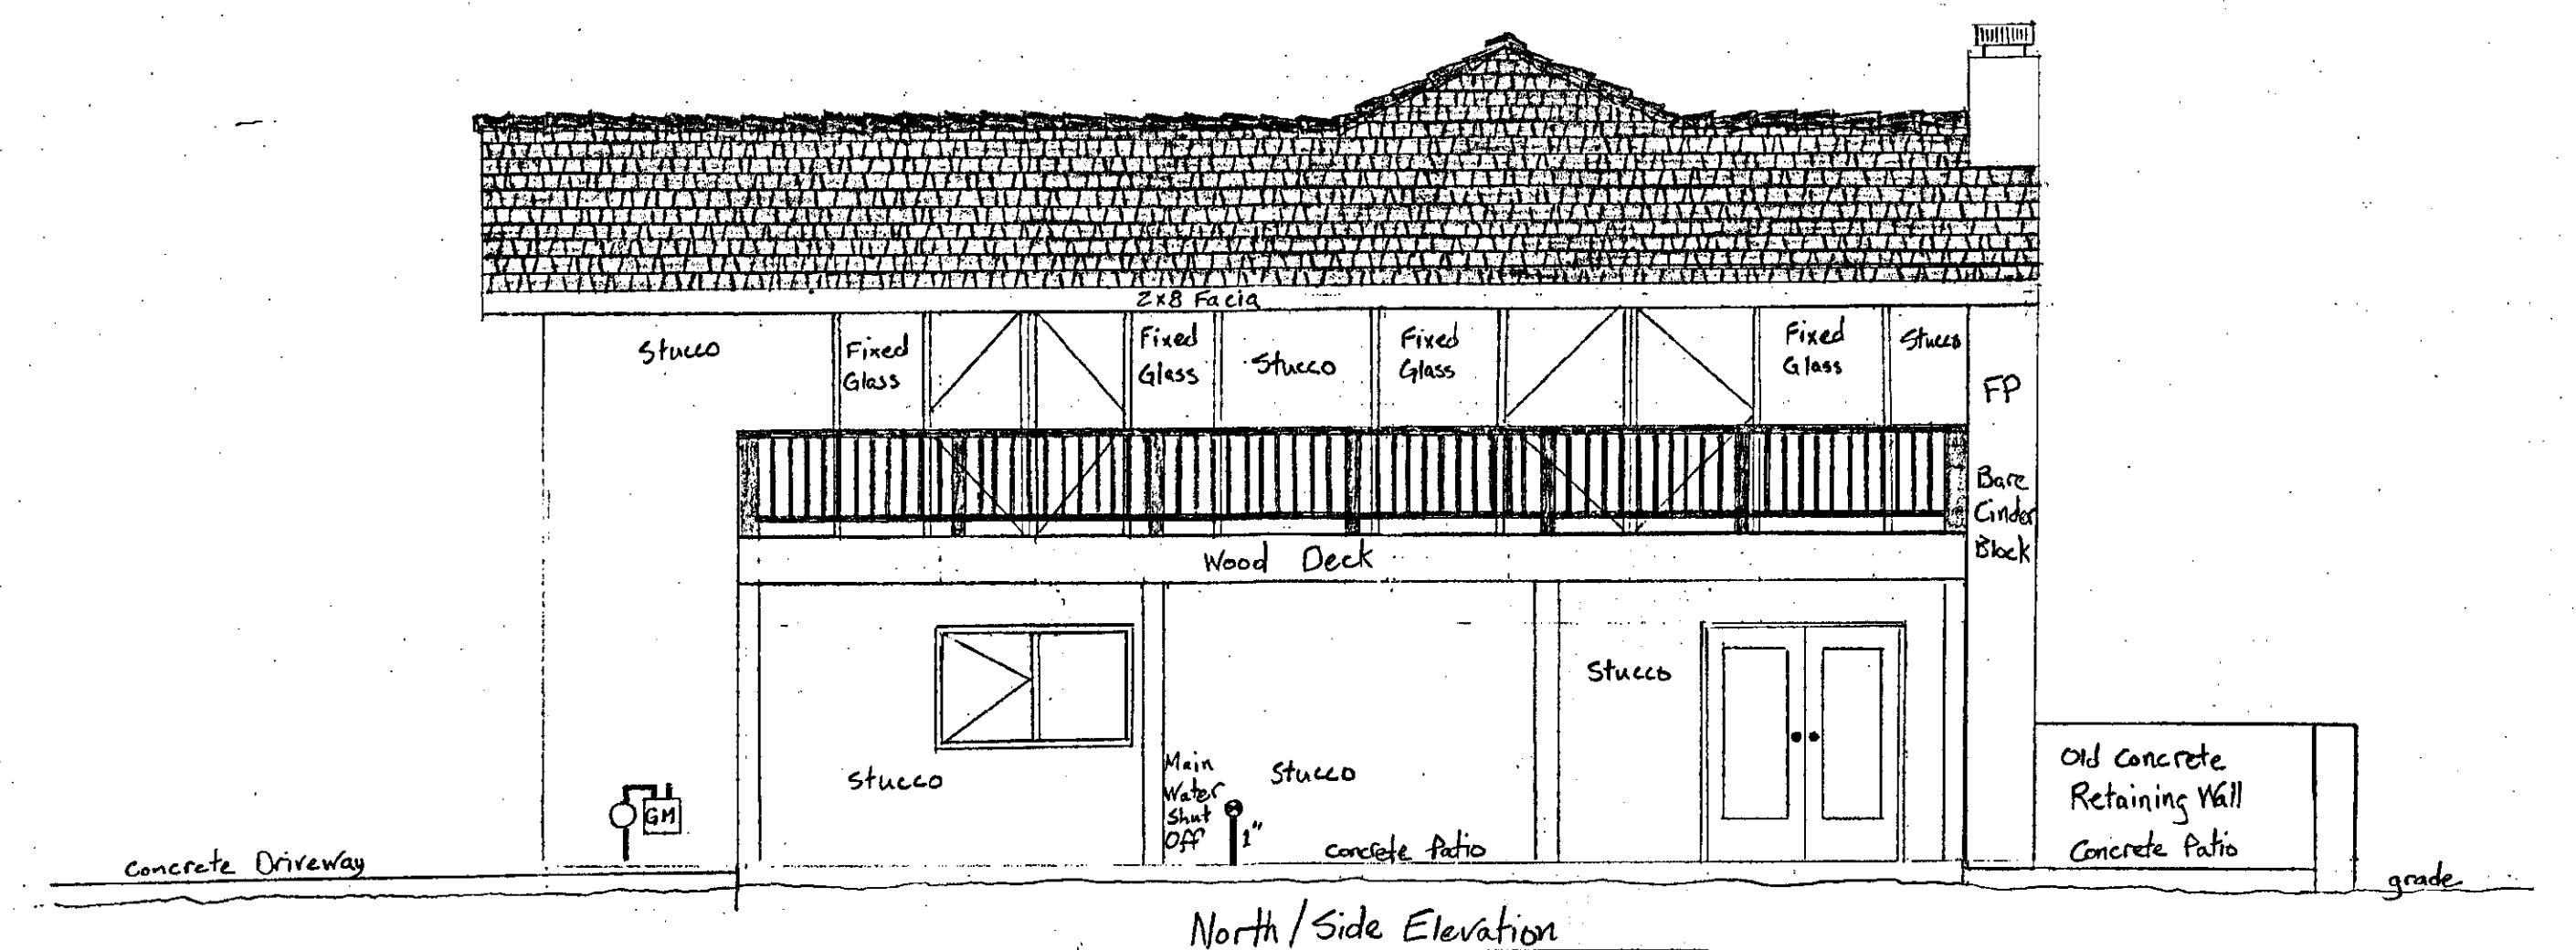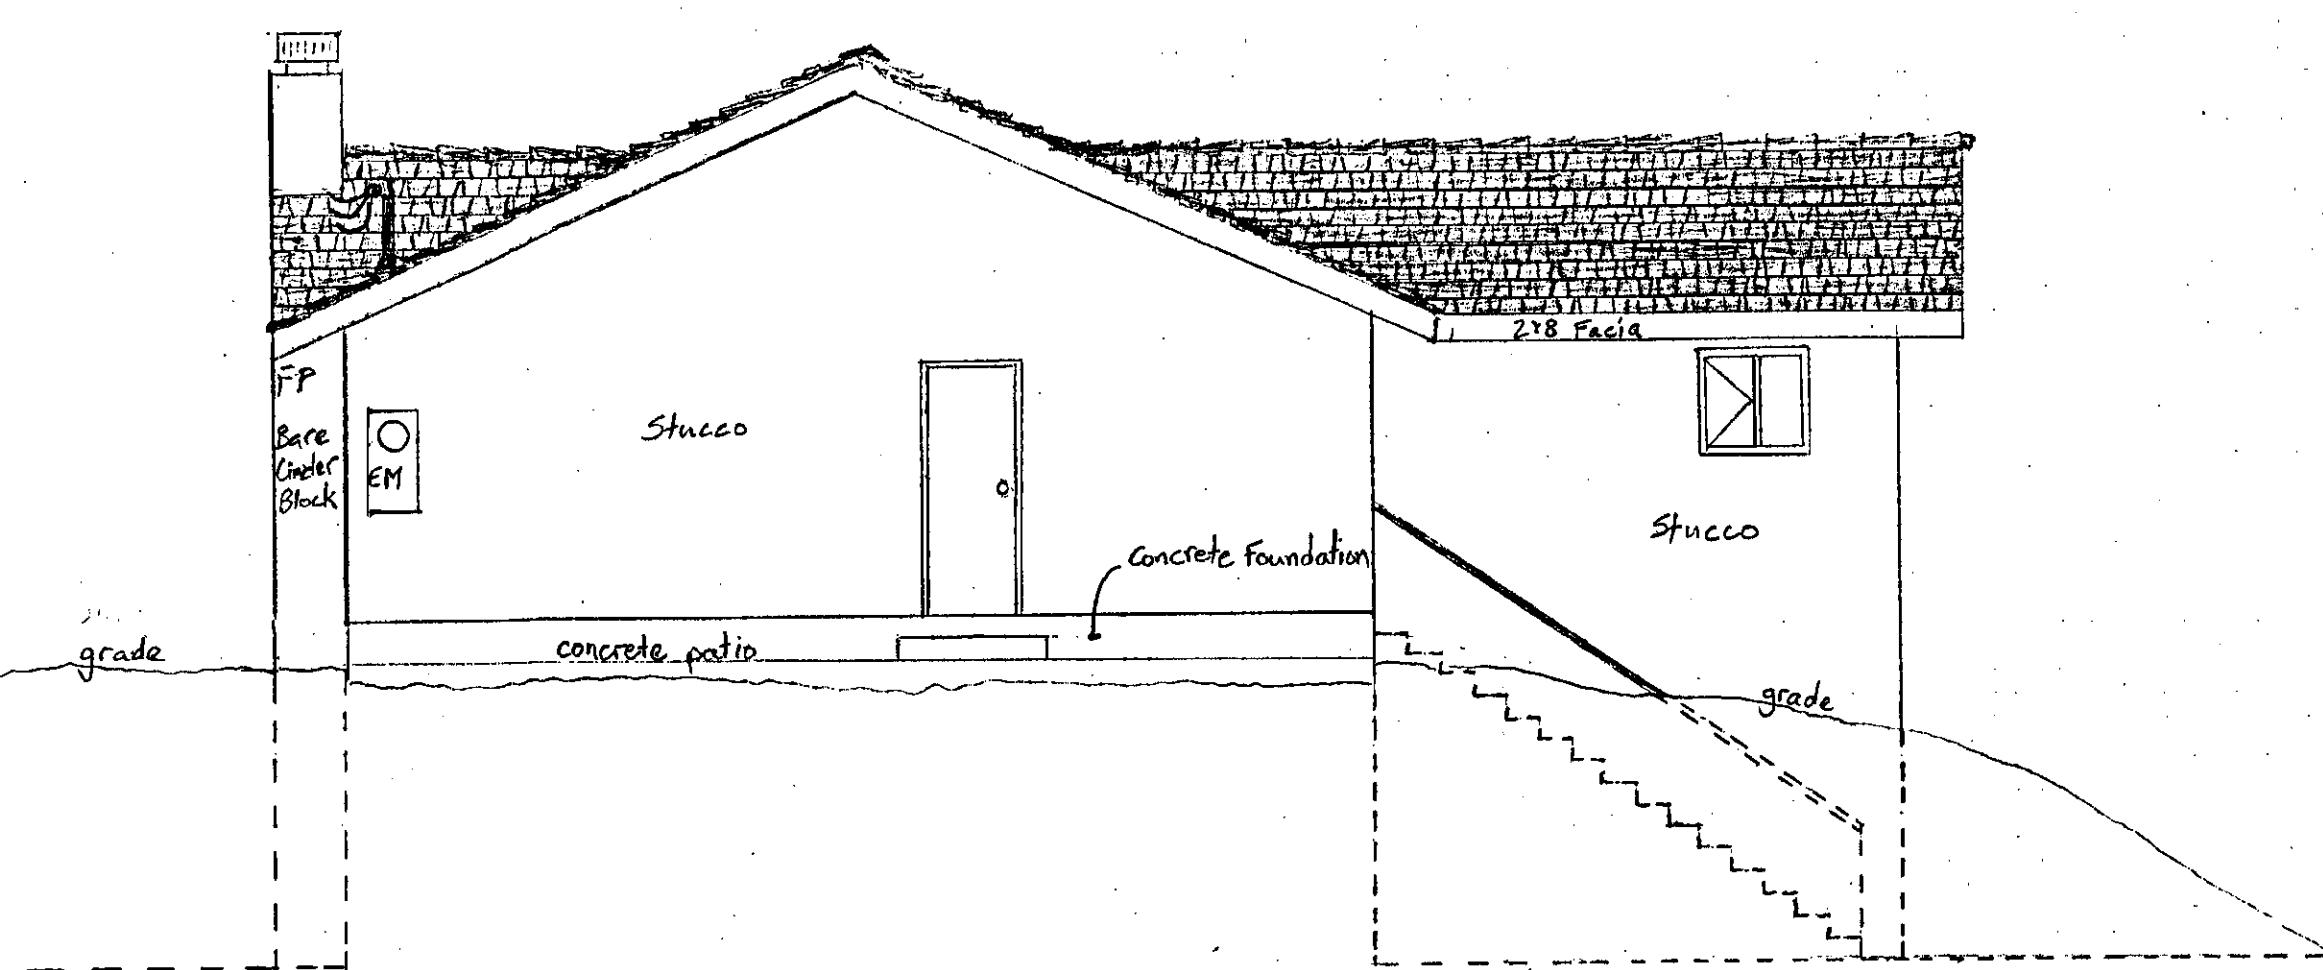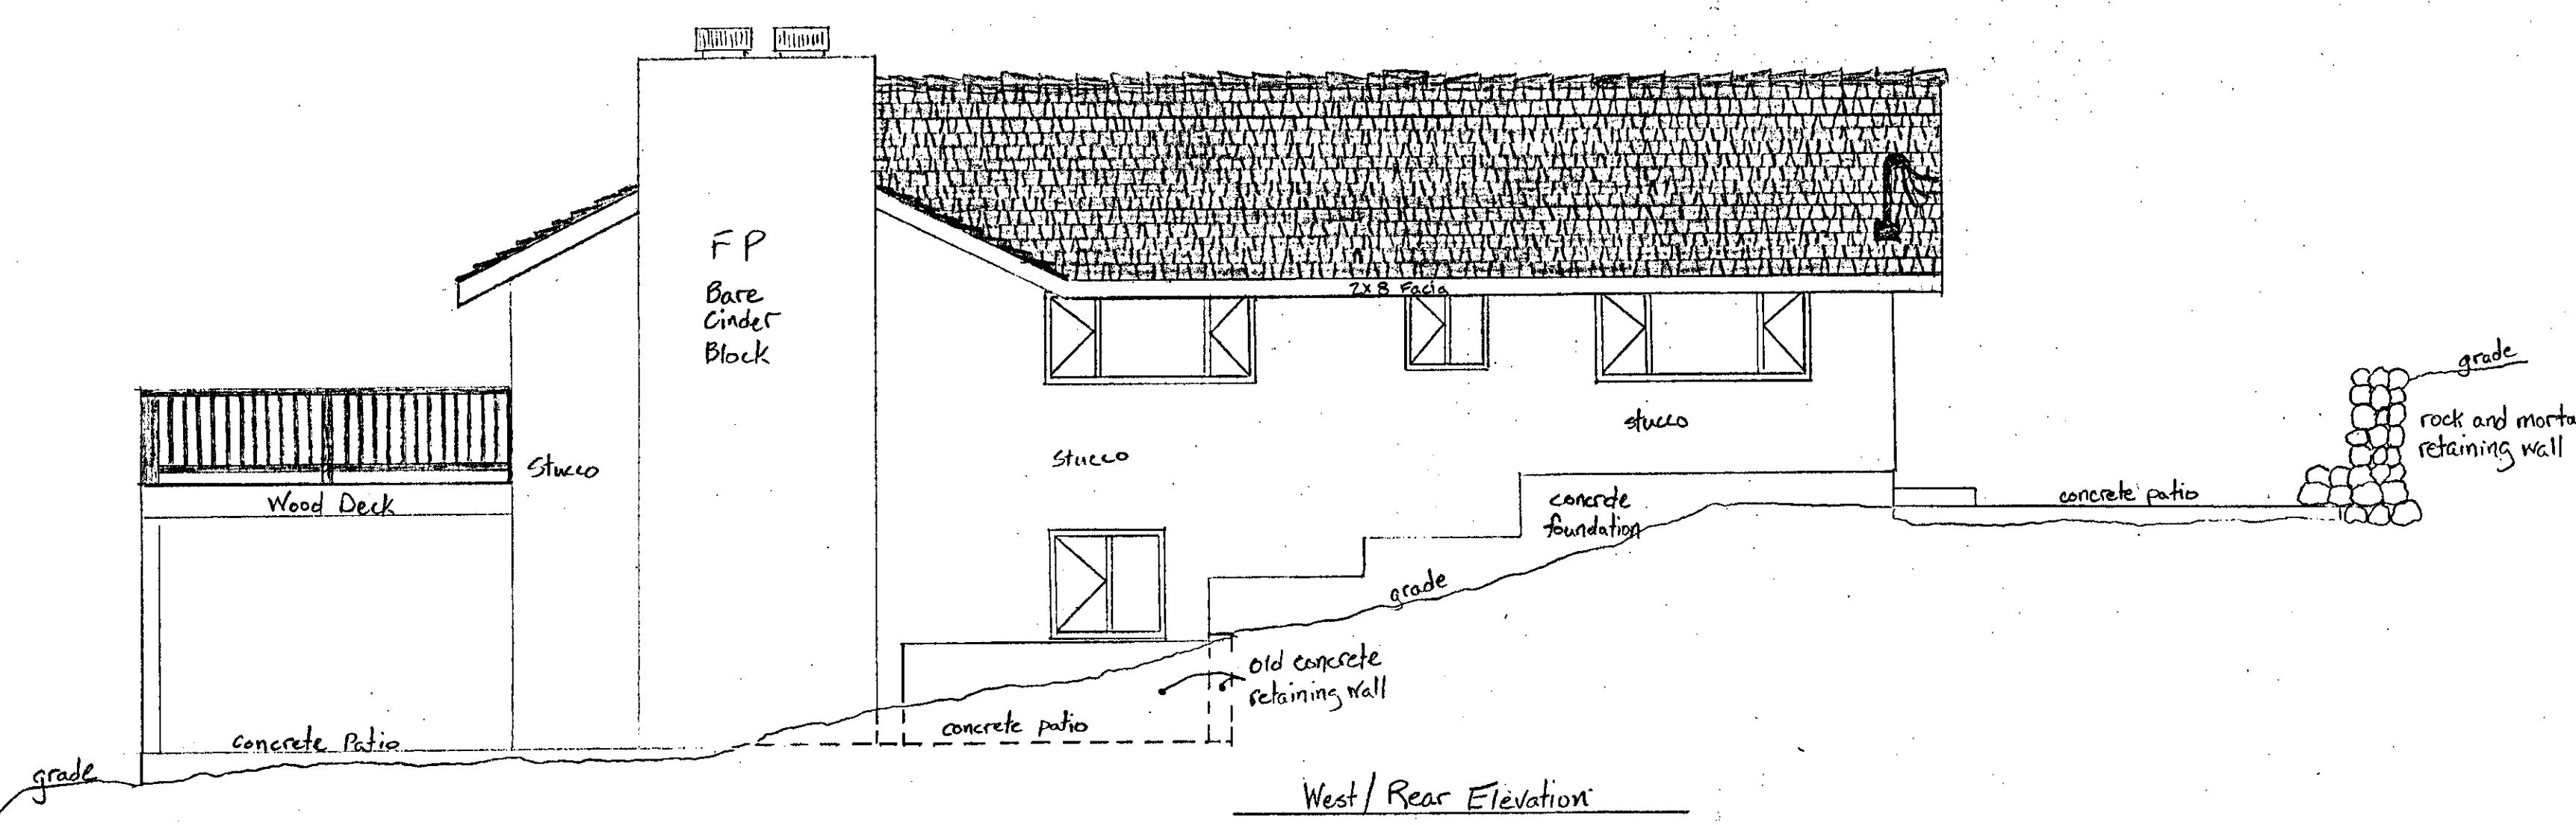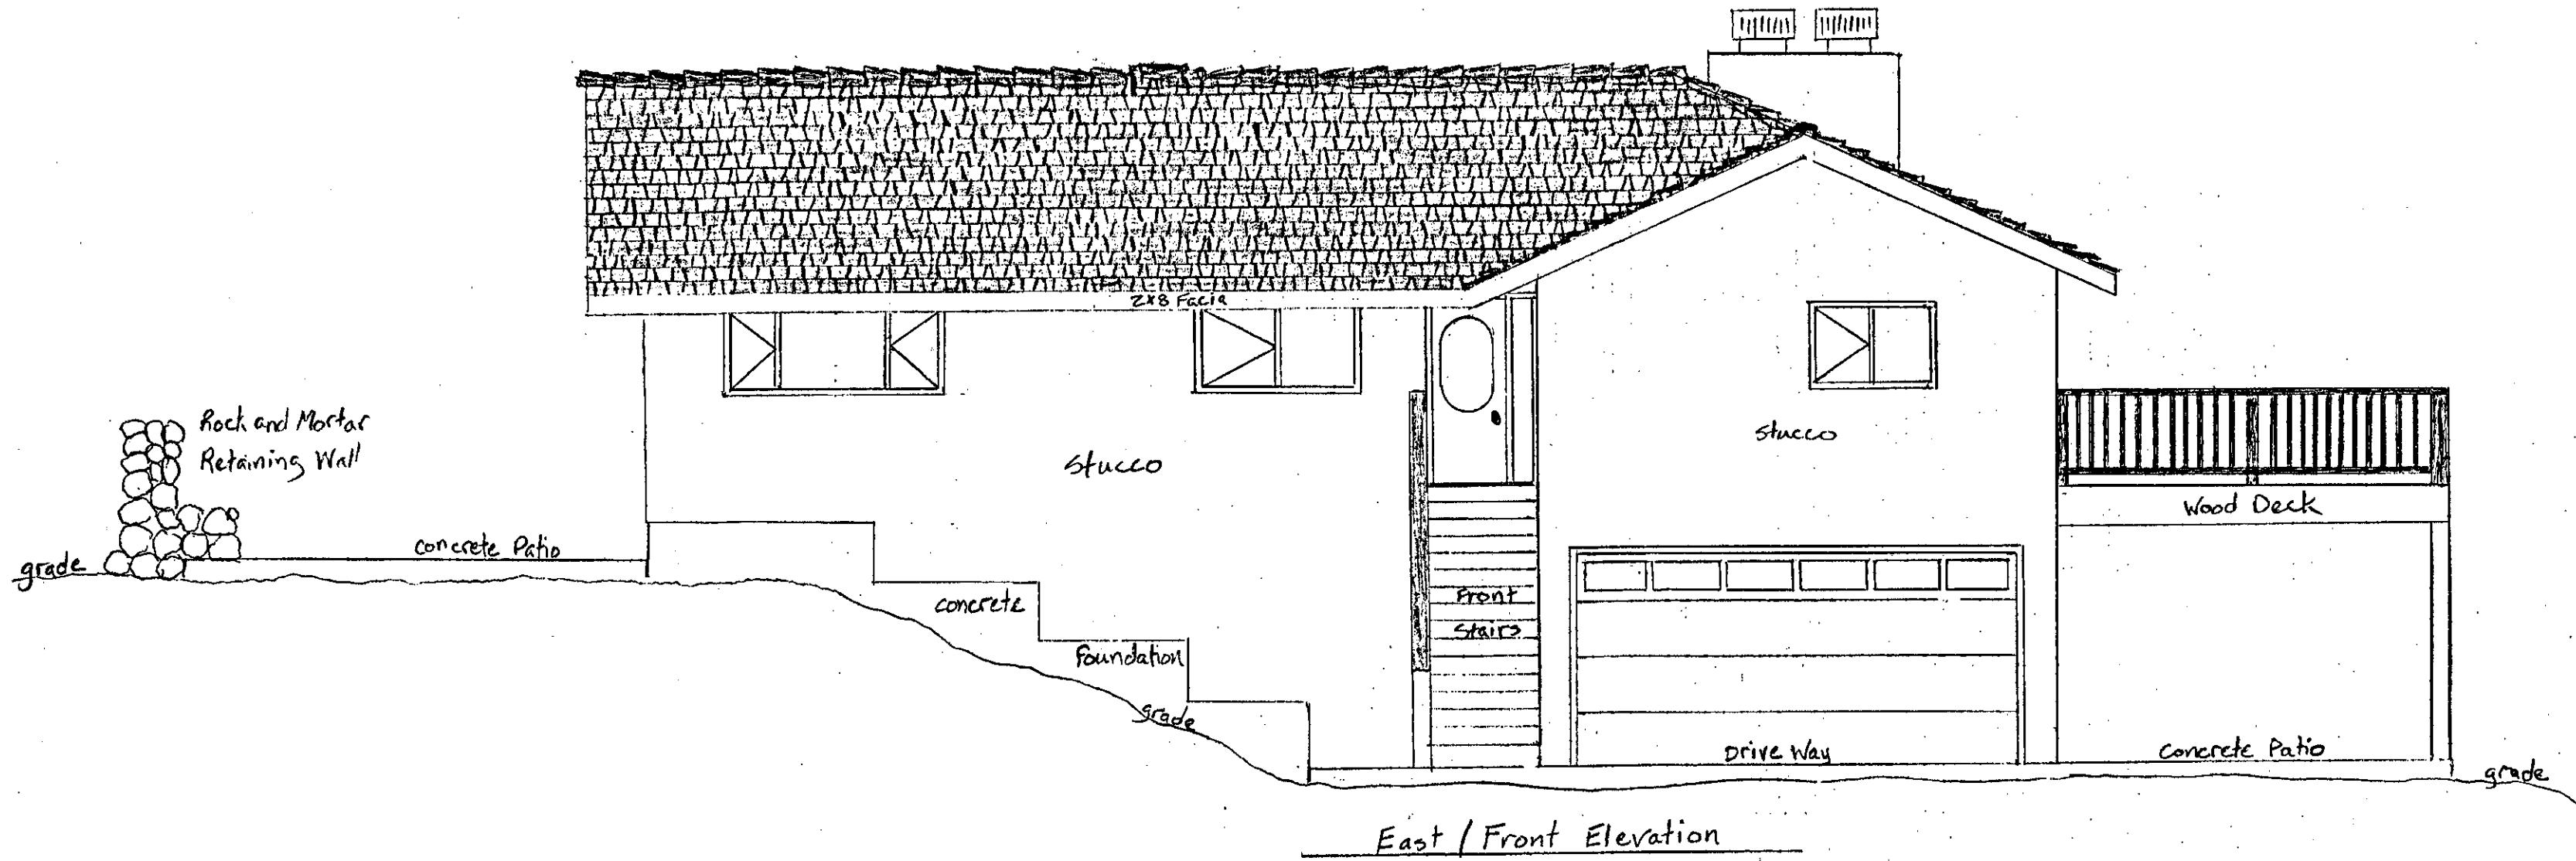

Date	9/5/2023
Scale	$\frac{3}{16}$ " = 1 foot
Drawn	CSL
Job	558 Grayson Rd.
Sheet	3B
of	10 Sheets

REVISIONS	
	BY

Proposed Floor Plan Main Floor/Window Schedule

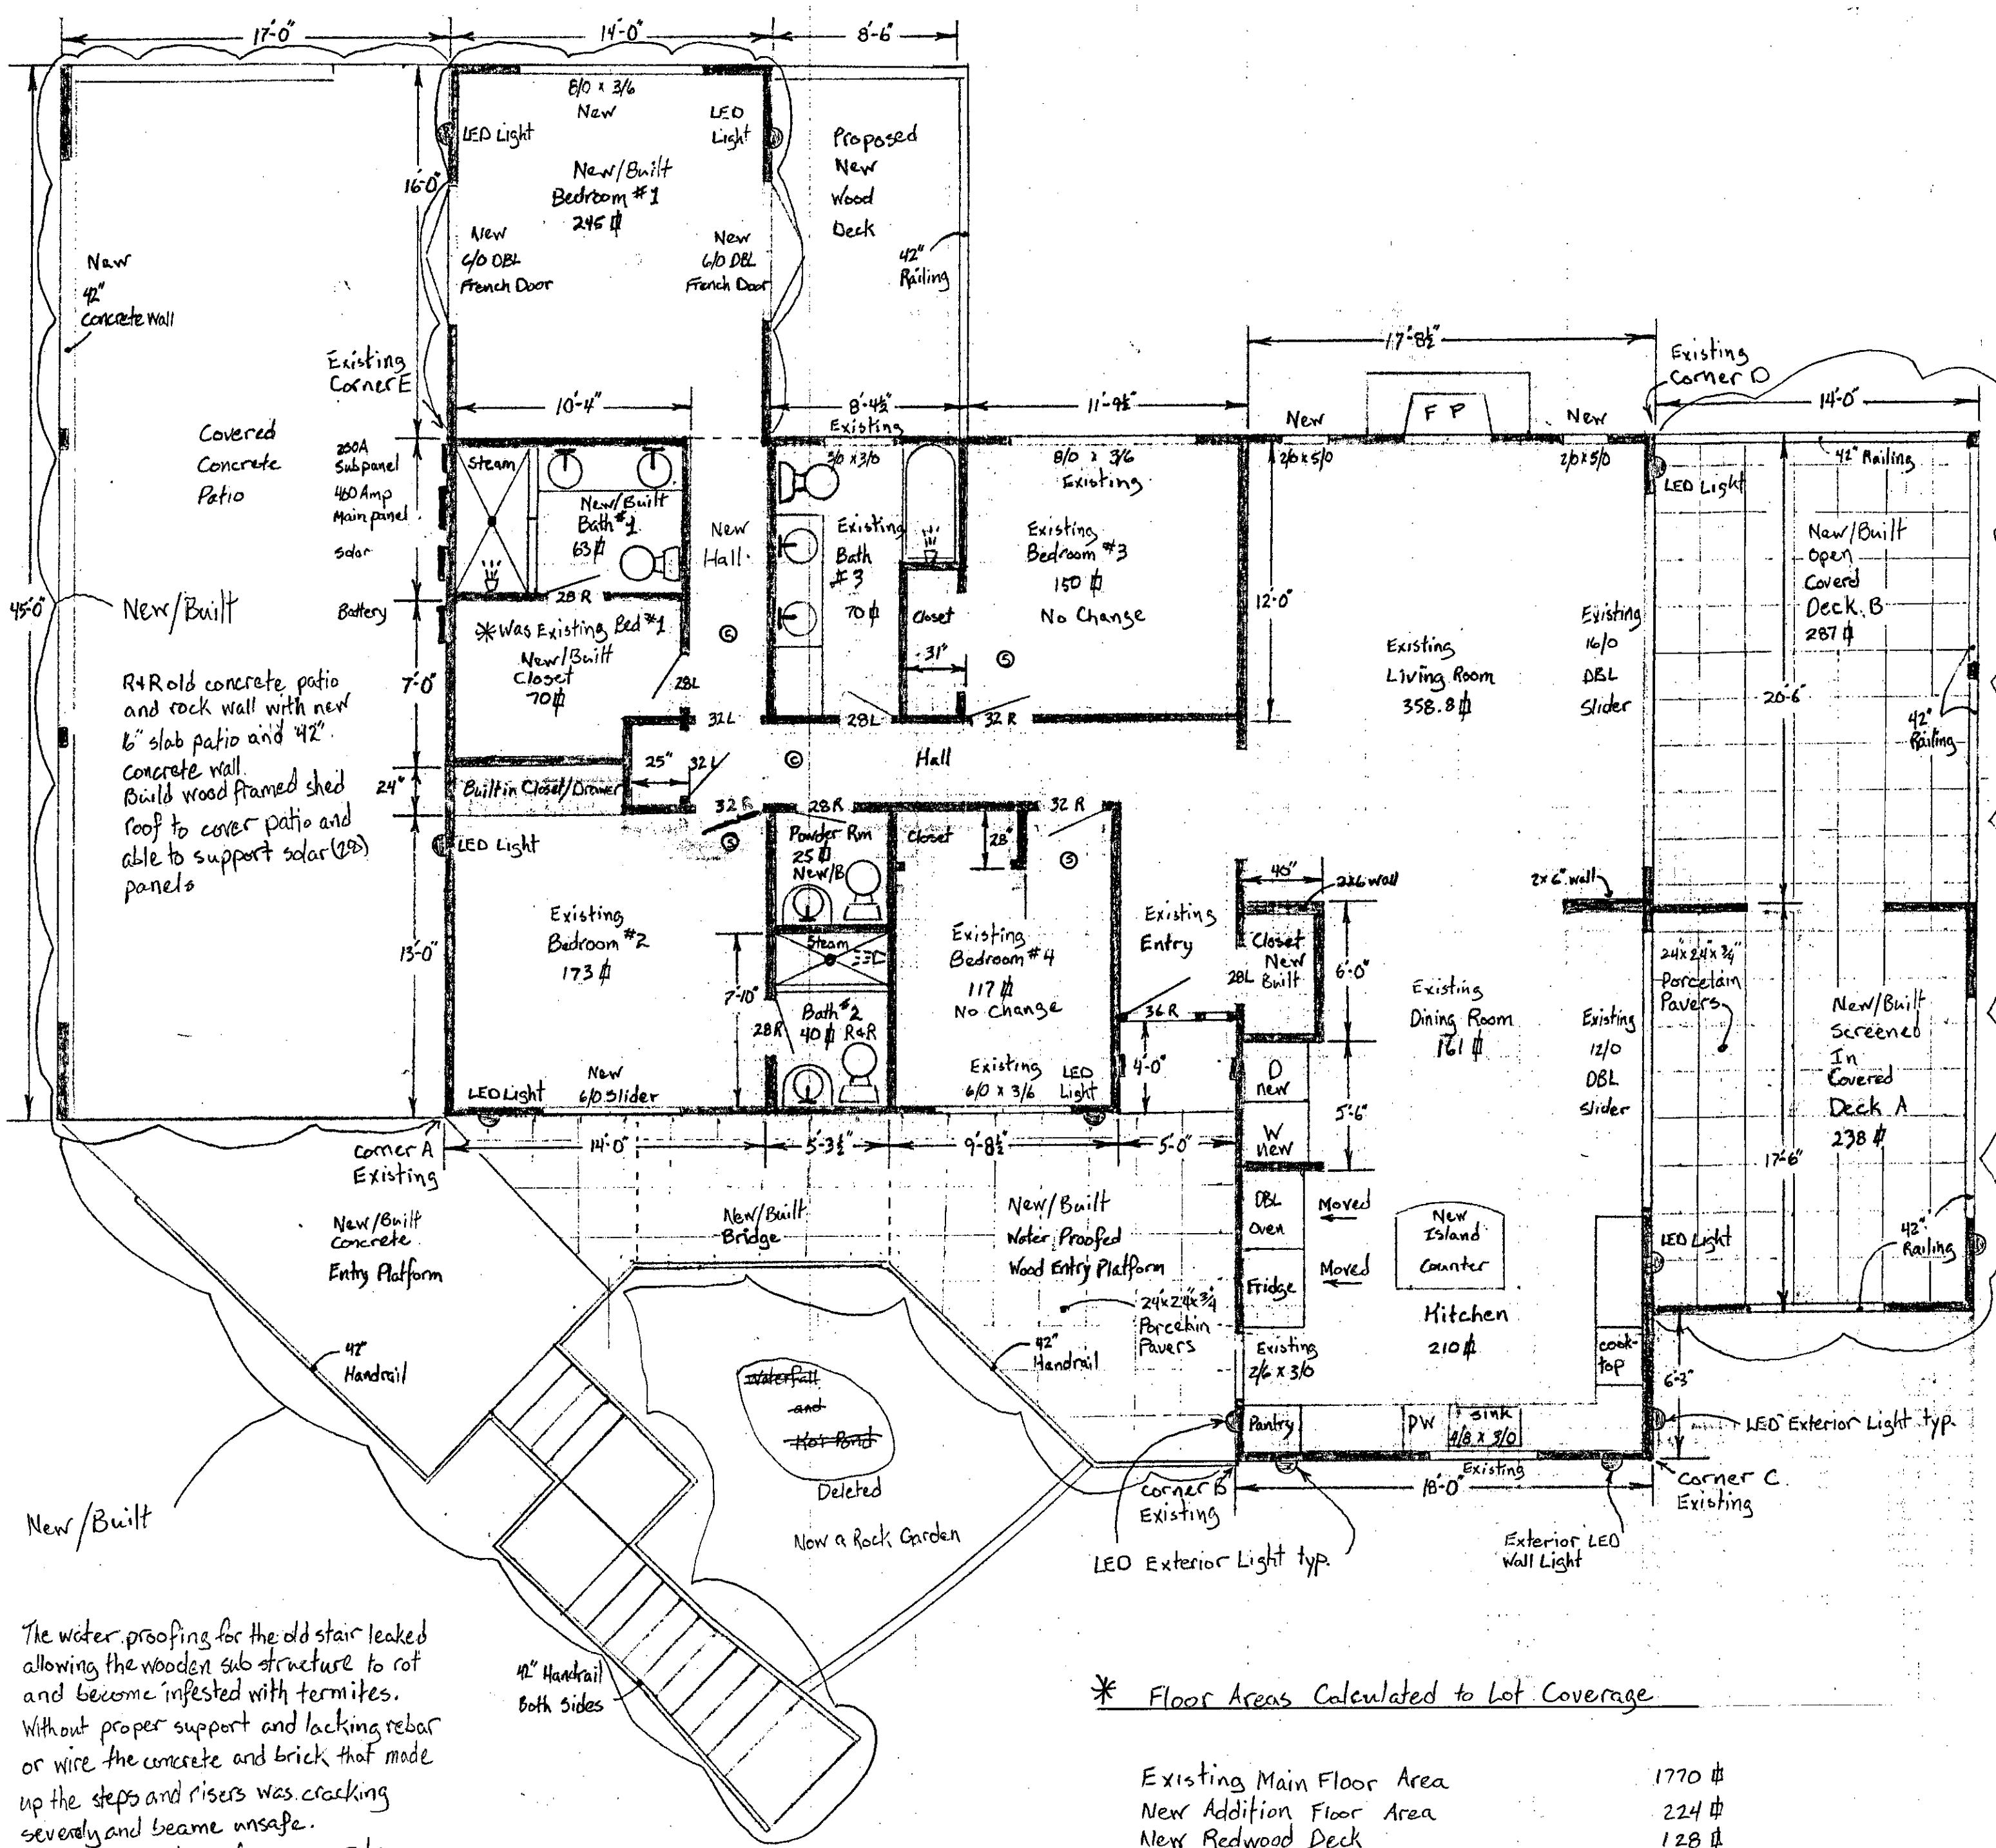

The water proofing for the old stair leaked allowing the wooden sub structure to rot and become infested with termites. Without proper support and lacking rebar or wire the concrete and brick that made up the steps and risers was cracking severely and became unsafe.

To make the entry safer a concrete and wood entry platform was built to the level of the front door and supplied with a 42" handrail. All construction is built on existing elevations. The new stairs utilizes existing gradient and requires no supporting structure. No more termites and no more rot.

* Floor Areas Calculated to Lot Coverage

Existing Main Floor Area
New Addition Floor Area
New Redwood Deck
New Covered Patio
New Covered Deck
New Entry Platform

1770 \$
224 \$
128 \$
765 \$
532 \$
567 \$

% Floor Area to Lot Coverage
 $1994 \div 66,990 \times 100 = 2.98\%$

% Foot Print Area to Lot Coverage
 $3986 \div 66,990 \times 100 = 5.95\%$

% New Floor area to Existing
 $707 \div 2,372 \times 100 = 29.8\%$

Window Schedule

Location	size	description	ratio floor area to glazed area %	EERO sqft/opening dimension %	Orientation E-W-N-South
N Living Room	2/0 - 5/0	LH Crank window	2.87%	N/A	W
E Living Room	2/0 - 5/0	RH Crank window	2.87%	N/A	W
Y New Bed #1	8/0 - 3/6	OX Window	11.47%	N/A	W
New Bed #1	6/0	DBL French door	17.17% Egress	Yes 6'0" x 7'0" = 42sf safety glazing	N
New Bed #1	6/0	DBL French door	17.17% Egress	Yes 6'0" x 7'0" = 42sf safety glazing	S - Shaded all day
New Bed #2	6/0	Slider	24.33%	Yes 3'0" x 7'0" = 21sf safety glazing	E
D Existing Bed #1	8/0 - 3/6	OX Window	(16.7%) Egress	(16.27%)	
F Existing Bed #2	8/0 - 3/6	OX Window			
L Existing Bed #2	32" RH	Exterior door			
E Existing Bed #2	2/6 - 3/0	Window	(18.87%)	(7.8%)	
T Existing Game R	6/0 - 3/0	OX Window			
E Existing Bed #3	8/0 - 3/6	OX Window	18.7% Egress	Yes 2'6" x 3'6" = 7sf	W
X Existing Bed #2	6/0 - 3/6	OX Window	17.9% Egress	Yes 3'8" x 3'6" = 10.5sf	E
I Existing Entry	42" RH	Exterior Entry Door			
S Existing Kitchen	4/0 - 3/0	OX Window	6.7%	N/A	E
I Existing Kitchen	2/6 - 3/0	OX Window	3.6%	N/A	S
N Existing Dining R	12/0	XOX Slider	52.2% > Egress	Yes 6'0" x 7'0" = 42sf safety glazing	N - shaded all day
G Existing Dining R	16/0	XOX Slider	31.3%	Yes 2'6" x 7'0" = 18sf safety glazing	N - shaded all day
E Existing Living R	6/0	DBL French door	18.3% Egress	Yes 6'0" x 7'0" = 42sf safety glazing	N - shaded all day
Existing Garage	6/0 - 3/0	OX Window	11.1% Egress	Yes 3'0" x 3'0" = 9sf	N - shaded all day
Existing Game R	4/4 - 4/0	OX Window	11.9% Egress	Yes 3'2" x 2'0" = 4.4sf	W
N New JADU Entry	36" RH	Exterior Entry Door			
E New JADU LRoom	5/0 - 4/0	OX Window	10.5% Egress	Yes	N/A
W New Storage R	32" LH	Exterior Door			N/A

Window Specs.

U-Factor 0.29 SHGC 0.22 Visible Transmittance 0.40 Air Leakage ≤ 0.3

* Fire Note:

- Emergency Egress and Rescue Openings shall have a minimum net clear opening of 5.7sf. Exception: the minimum net clear opening for grade-floor emergency egress and rescue openings shall be 5sf.
- The minimum net clear opening height shall be 24", width shall be 20".
- The bottom of opening can be no more than 42" from finished floor.
- single or multiple-station smoke alarms shall be installed and maintained in the following locations
 - On the ceiling or wall outside of each separate sleeping area in the immediate vicinity of bedrooms.
 - In each room used for sleeping purposes
 - In each story within a dwelling including basements but not including crawl spaces and uninhabitable attics.
- Where more than one smoke alarm is required, the smoke alarms shall be interconnected in such a manner that the activation of one alarm will activate all alarms in the individual unit.
- Carbon Monoxide/smoke alarms shall be located in each story
 - Combination Carbon Monoxide/smoke detector
 - Smoke detector only
- Since new living area compared to existing is only 22.8% it is expected that the existing structure will be exempt from requiring fire sprinklers

SB8 Canyon Rd. Emerald Hills 94023

Owner: David and Ha Saunders

Address: 2320 Yucca Glen Dr. Los Altos Hills 94022

Contact: Colin Lucco 108-68-5002 / 301-1982@gmail.com

Date 5/5/2023

Scale 3/16 = 1 foot

Drawn CSCL


Job SS8 Canyon Rd.

Sheet 4

of 10 Sheets

REVISIONS	BY

Proposed Floor Plan Basement/JADU Floor

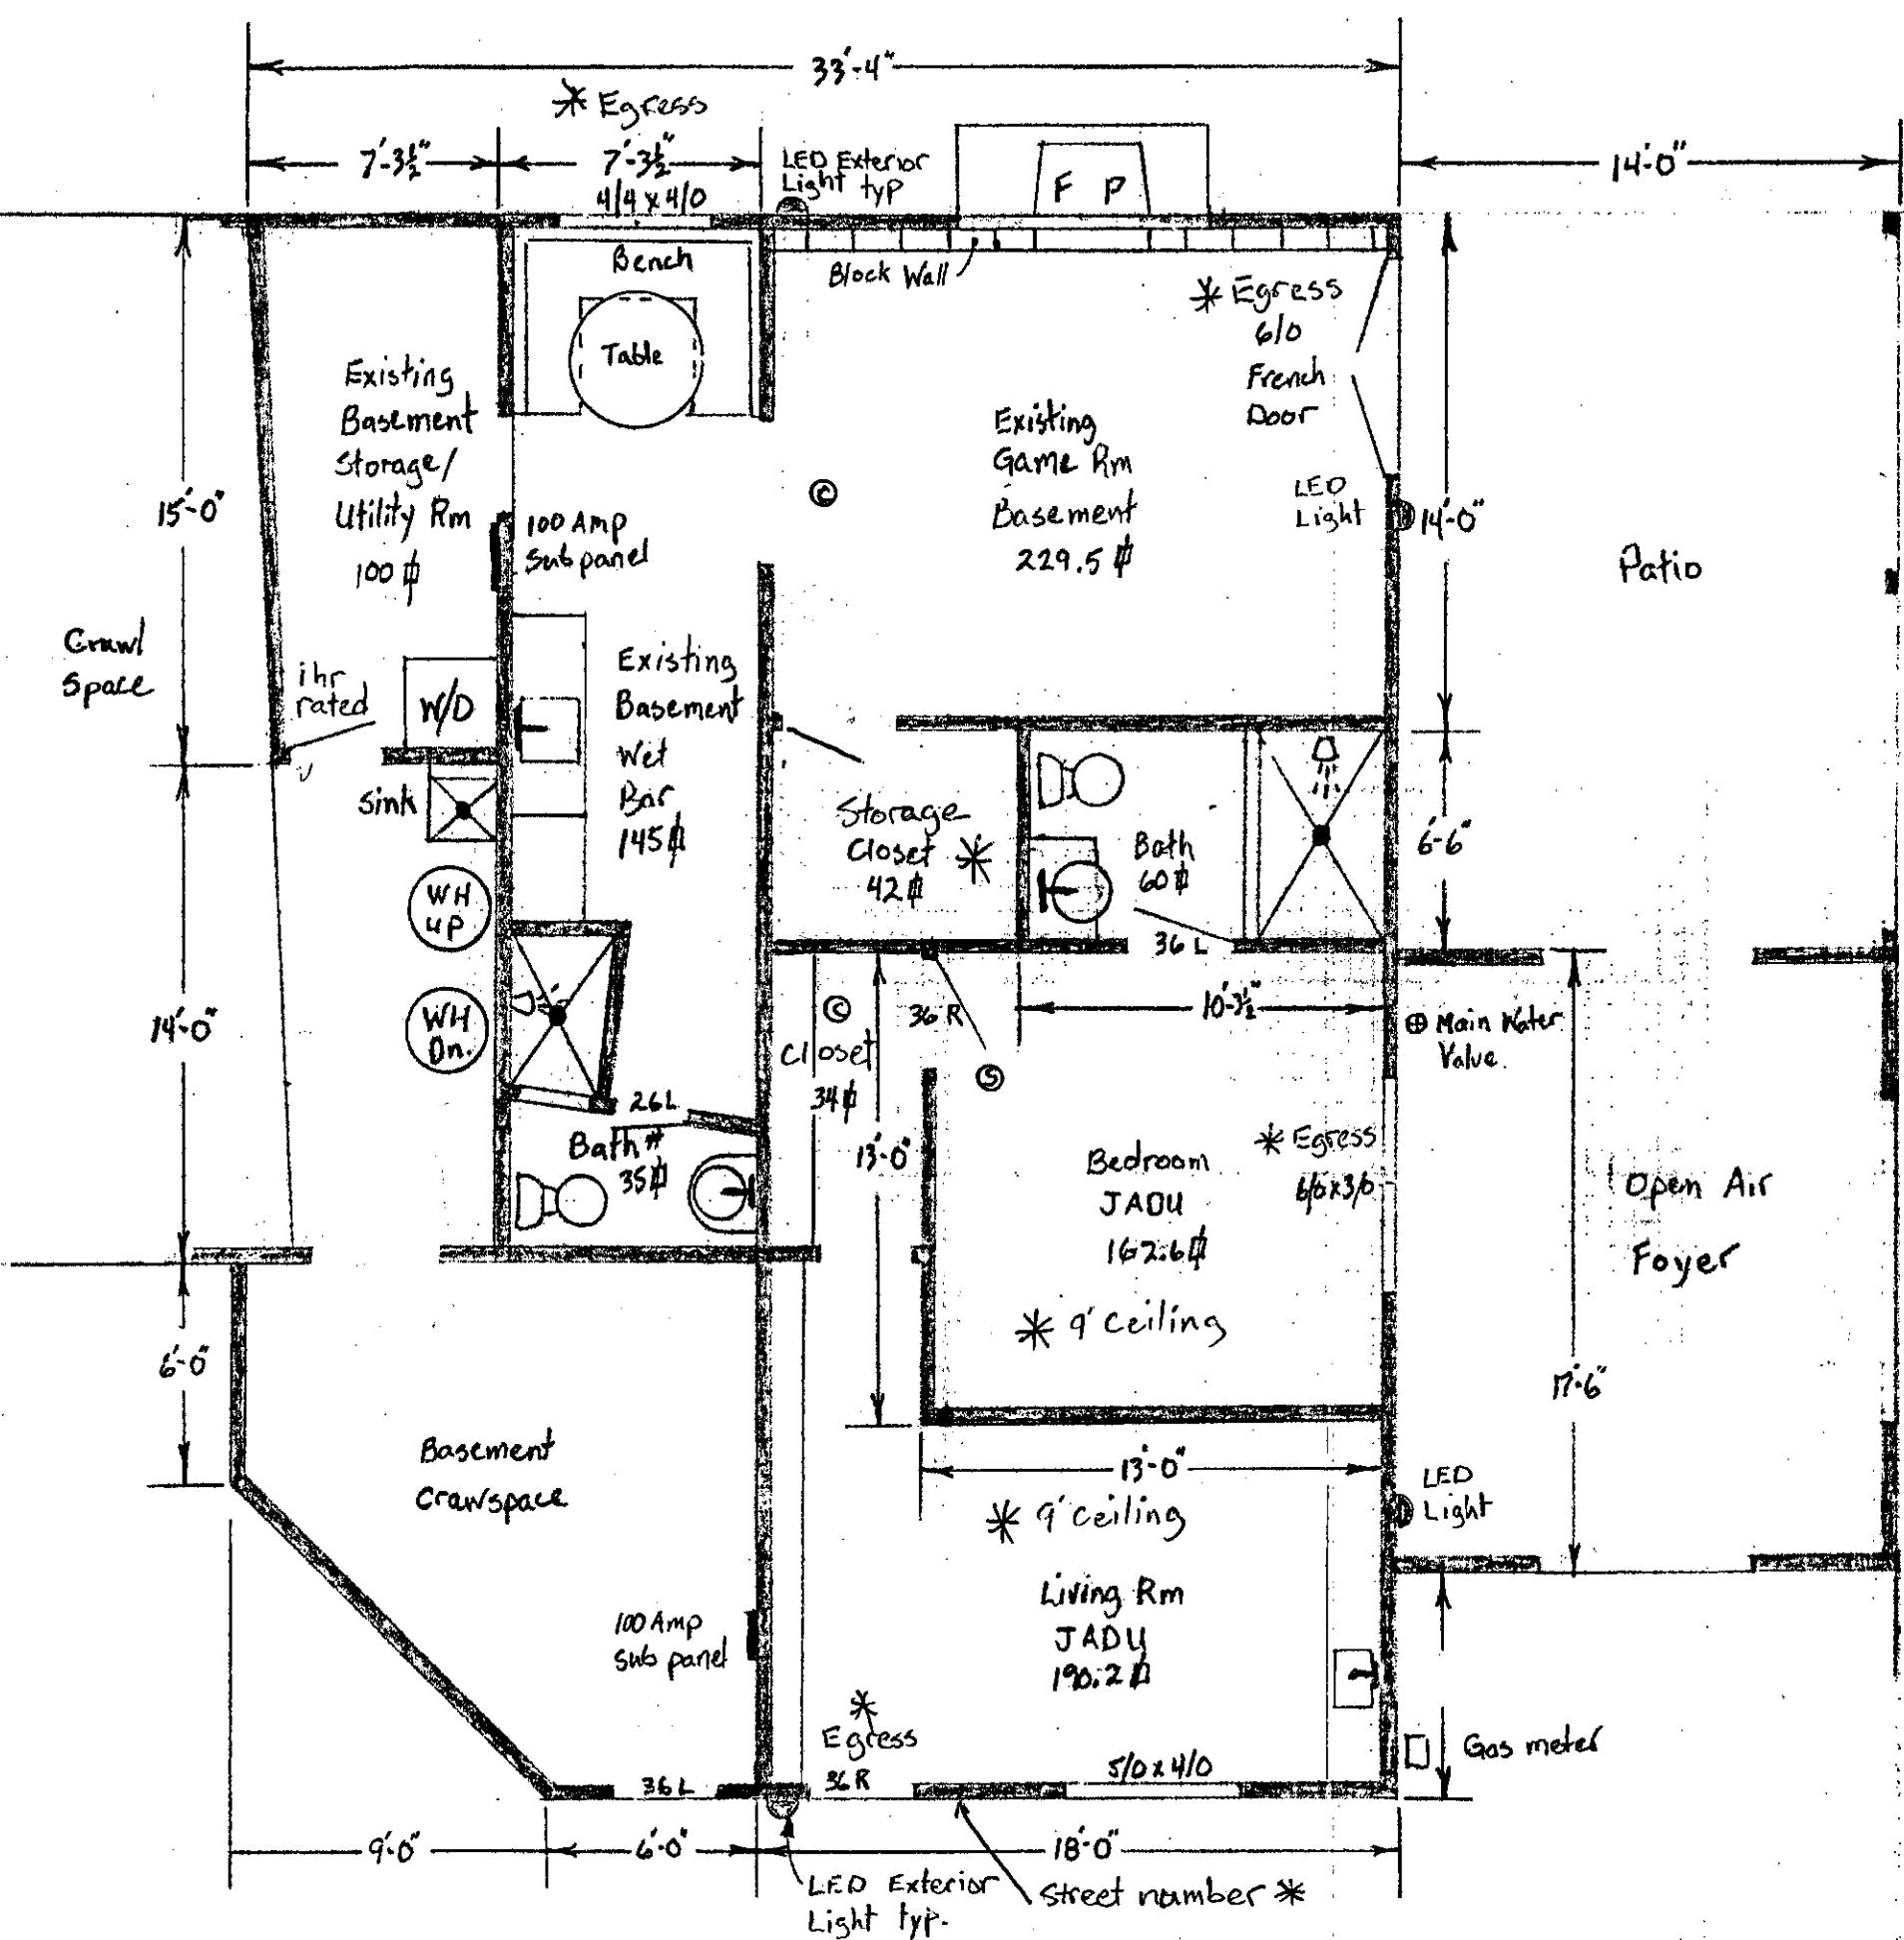

Basement/JADU Floor Plan

* Fire Notes:

- Combination Carbon Monoxide/Smoke Detector required next to sleeping areas and on each floor.
- Smoke Detector required in each bedroom.
- There has to be at least 1 hour fire separation between JADU and rest of house.
- House number needs to be visible by the door at least 6' above finished floor.
- Egress door/windows marked on plans. Specs found window schedule on page 4


* % Lot Coverage

Basement/Gameroom	602 sf	>17% lot coverage
Downstairs Patio	532 sf	>17% "
JADU	485 sf	0.72% Lot coverage

588 Canyon Rd. Emerald Hills 94062
 Owners: David and Ha Saunders
 33200 More Glen
 Contact: Calin Lucero 408-665-5002 / squell1978@gmail.com

Date 5/1/2023
 Scale $\frac{1}{64}$ = 1 foot
 Drawn CBL
 Job 558Canyon Rd.
 Sheet 5
 of 1 Sheets

Exterior Elevations

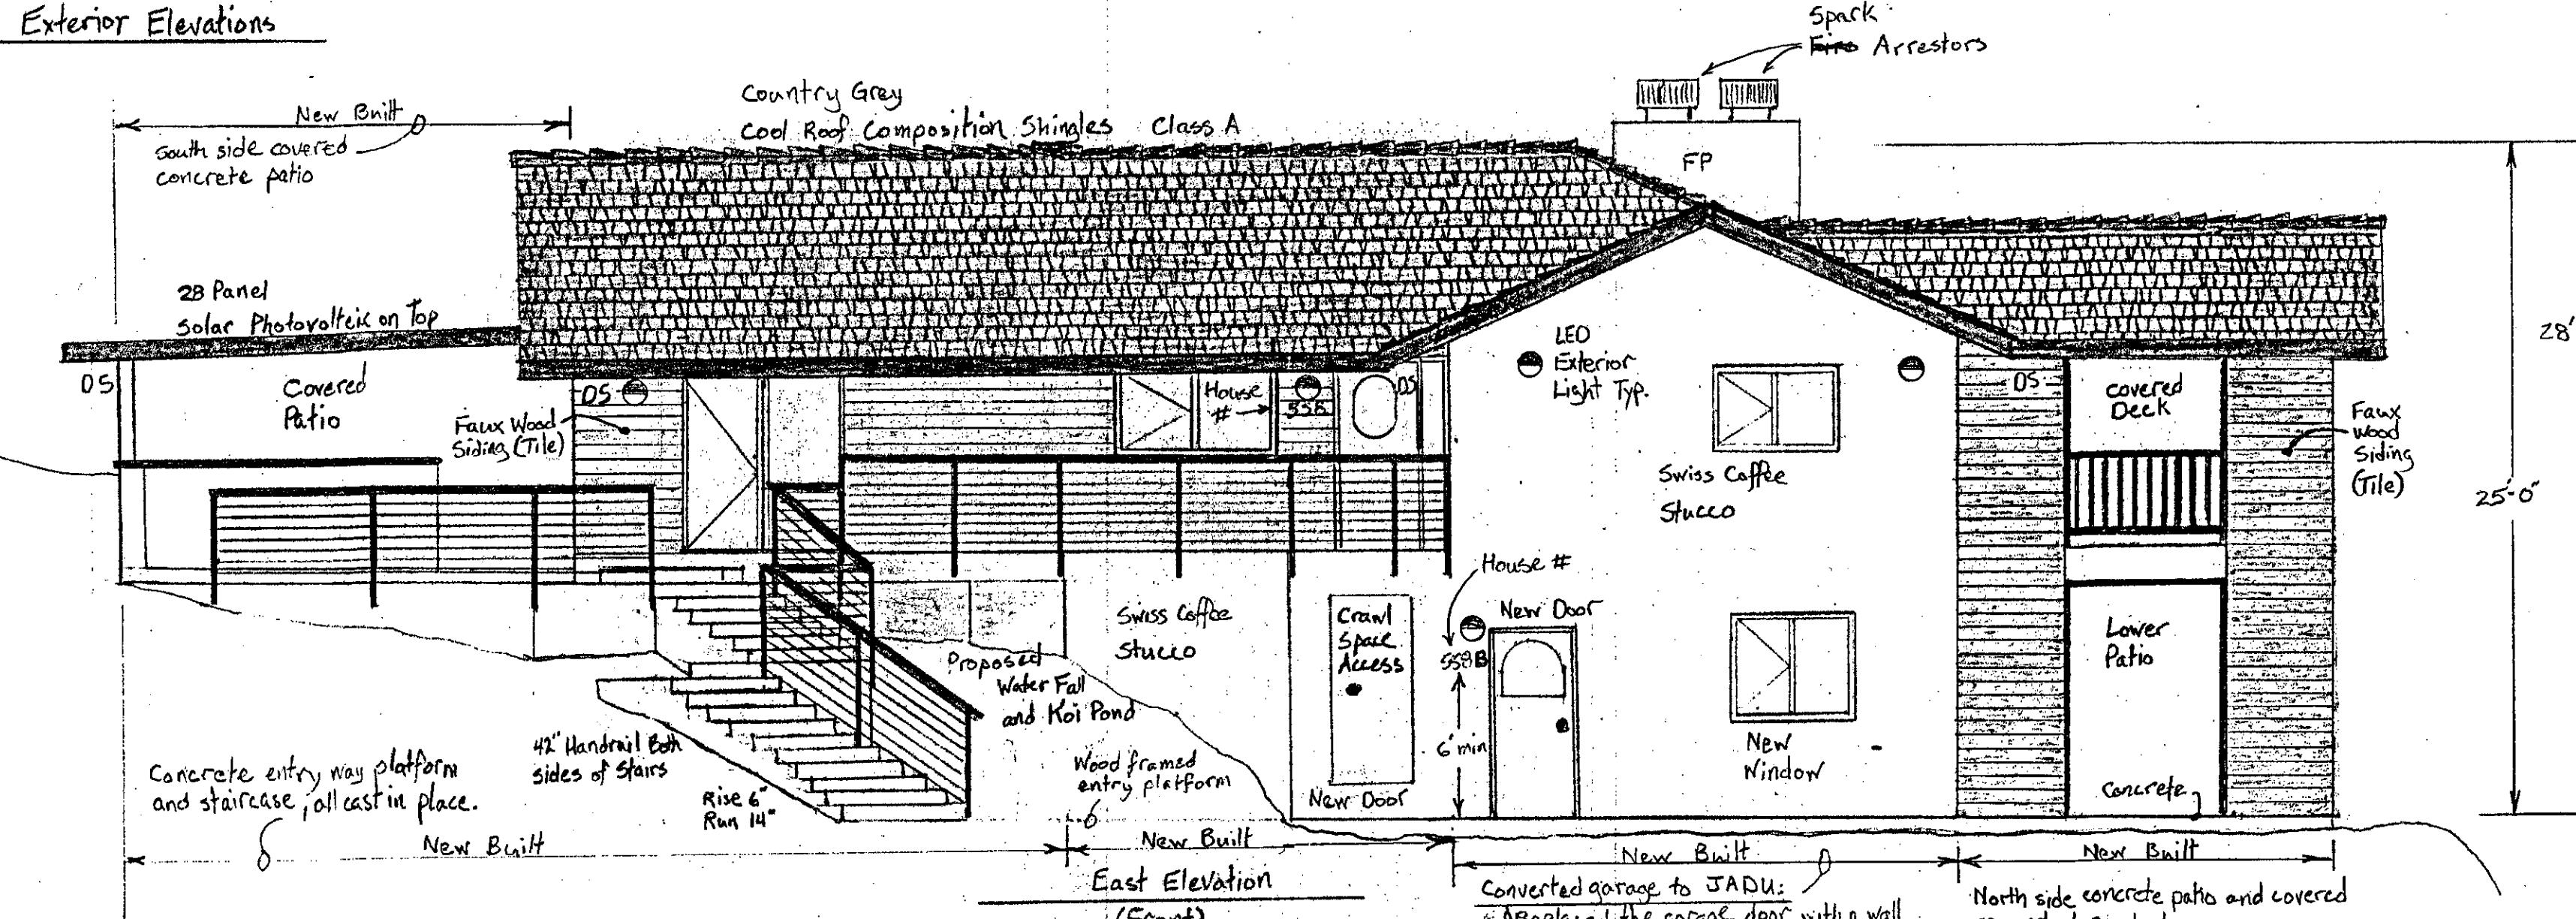

* Fire Note

- Street/House number are to be mounted next to front entry way of each unit no lower than six feet from finish grade.
 - ADU/JADU addressing shall be identified by same address number as primary residence followed by letters in sequence beginning with letter "B".
 - Construction, projections, openings and penetrations of exterior walls of dwellings and accessory buildings shall comply with CRC 2022 Table R302.1(1). Foundation vents installed with this code are permitted.

Exterior Finishes

Roofing: Light brown California cool roof composition shingles for sloped roofs.
Matching light brown roll on/torch down for shed roofs. Color-Country Grey
Walls: Smooth Santa Barbara style stucco painted Swiss Coffee - Kelly Moore.

paint finish is satin for easy cleaning.

Exterior: painted a dark brown (Kelly Moore - Americana), Semi-Gloss.

Windows: Milgard Tuscan Series V400 VNL no grids

handrails: Upper deck - wood, painted Americana

stairs and front entry - metal/cable, painted Americana

oof drainage: Continuous gutter with down spouts draining into:


- 1) Rain water holding tanks with piping to irrigation.
- 2) Vegetative areas and away from impervious surfaces

Aux Wood Siding - Porcelain 12 x 59 Tiles

Exterior Lighting - LED downward shining wall sconces

floor tile for entry and upstairs deck to be 24x24x $\frac{3}{4}$ porcelain
Brown

* Notes: Materials and Finishes called out on separate call sheet to be supplied with the plans.

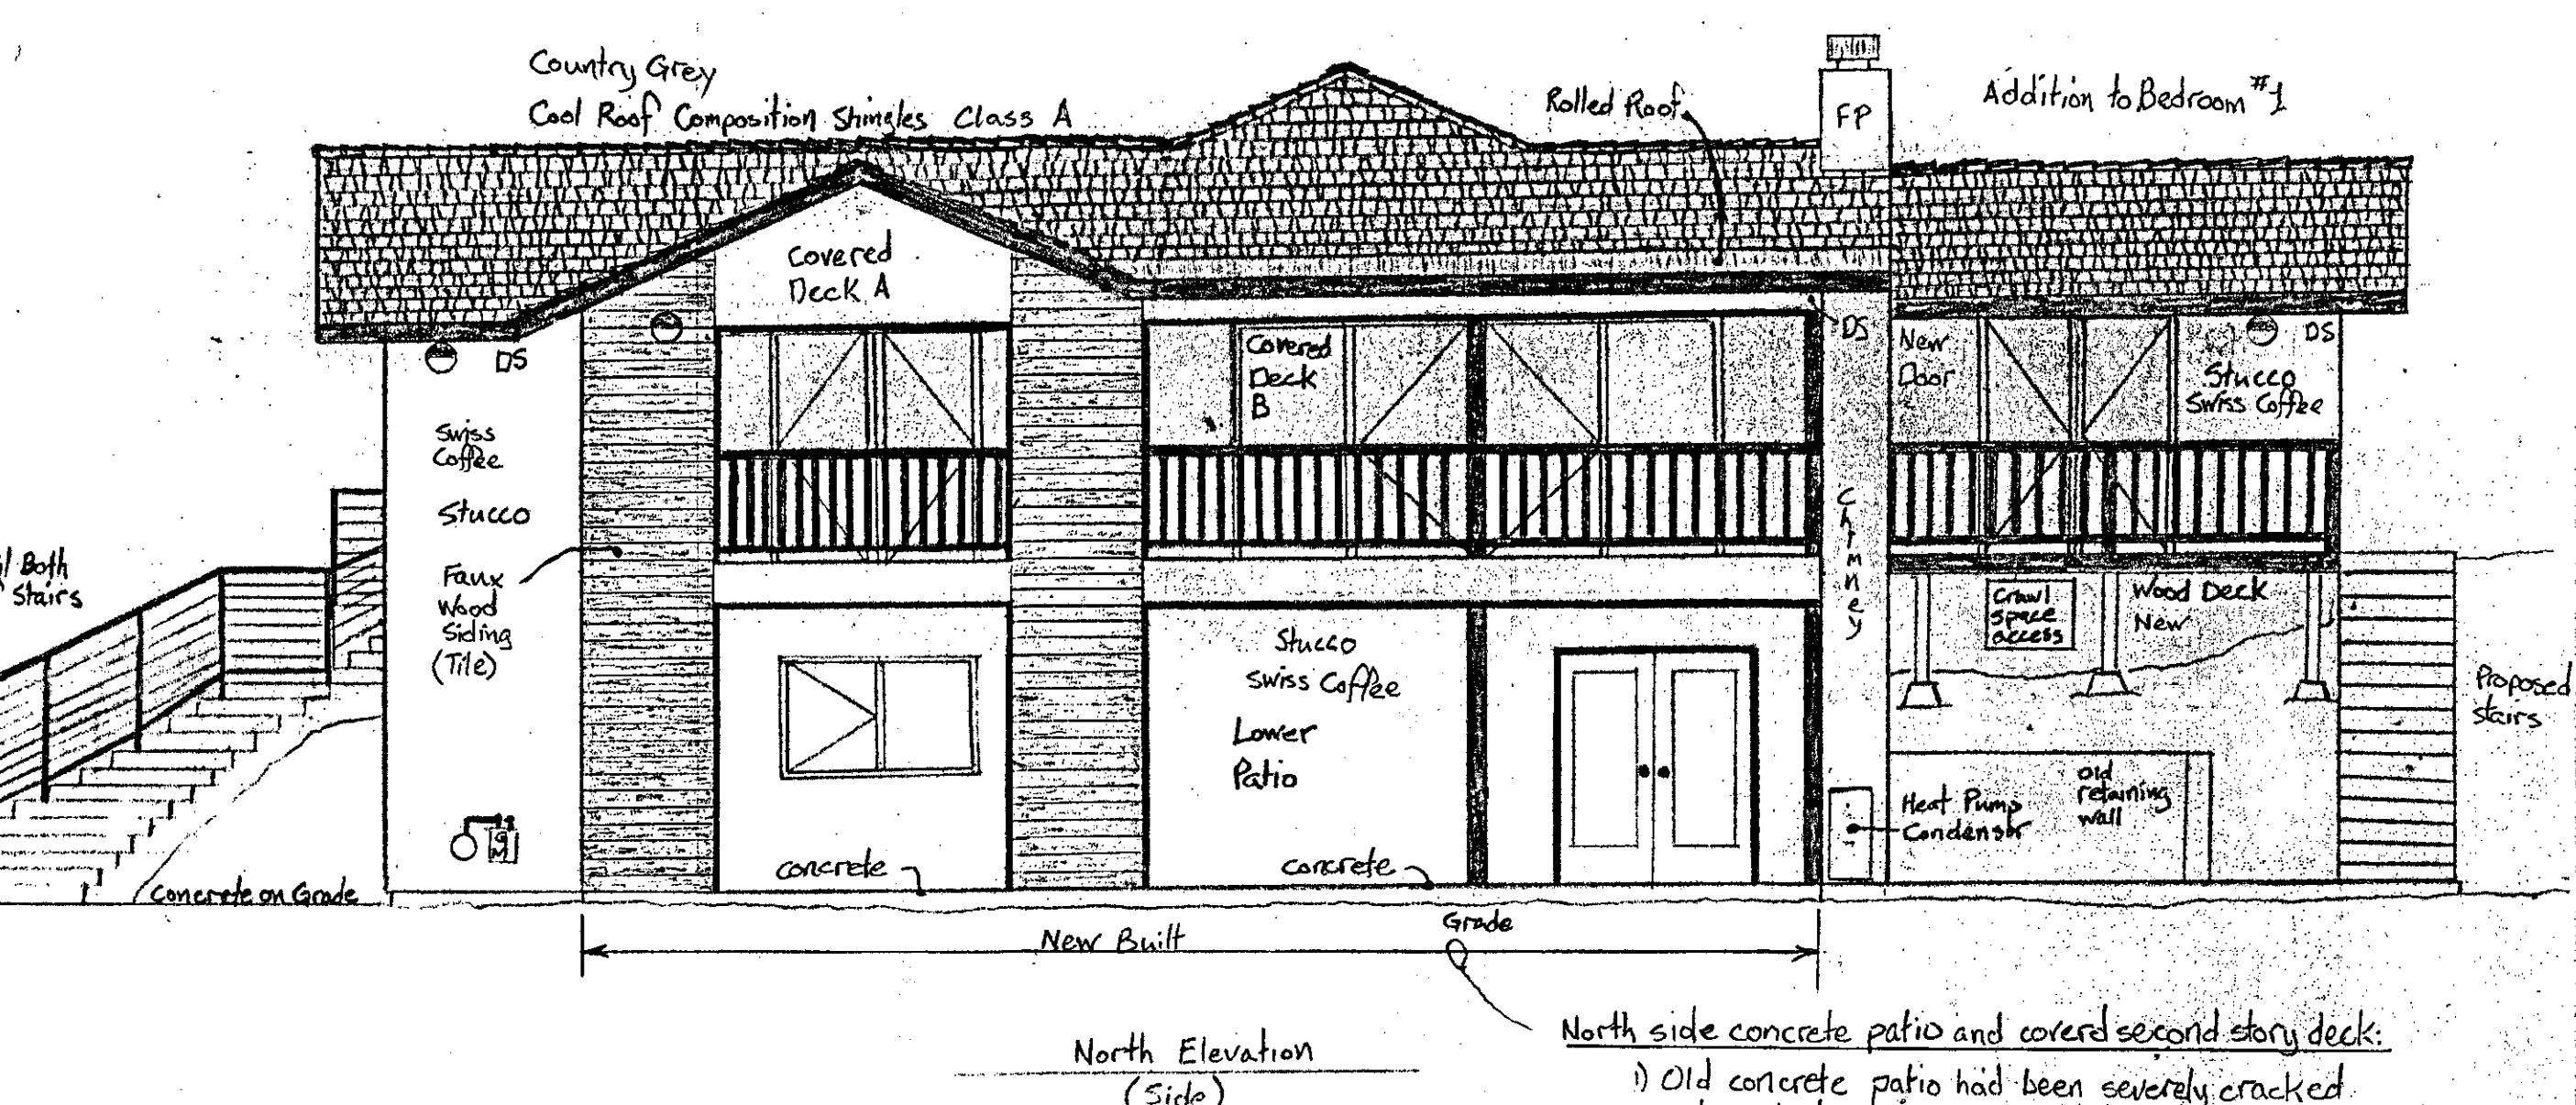

North side concrete patio and covered second story deck;

- 1) Old concrete patio had been severely cracked and pushed up by tree roots from large Oak Trees planted only a couple of feet from the patio's edge. The old second story deck was severely rotted and infested with termites.
 - 2) New 16" x 18" footings were dug in the same footprint as the old concrete patio. The new foundation and 6" slab were poured over #4 rebar reinforcement, see details 
 - 3) The new deck and roof structure were stick framed to the standards of any 2 story dwelling. The deck was divided into section A and B. Section A has a gable roof and section B has a shed roof to provide architectural interest. Covered deck A will be more like an outdoor living space.

558 Canyon Rd. Emerald Hills 94062
Owners: David and Ha Saunders
23200 Mora Glen Dr. Los Altos Hills Ca. 94022
Contact: Calvin Lucco 408-668-5002 / squeld1998@gmail.com


Date 5/5/2023
Scale $\frac{1}{16}$ = 1 foot
Drawn CSL
Job 558 Canyon Rd.
Sheet 6
of 10 Sheets

REVISIONS	BY

Landscape Plan:

558 Canyon Rd. Planting and Removal Plan

Scale 1mm = 1 foot

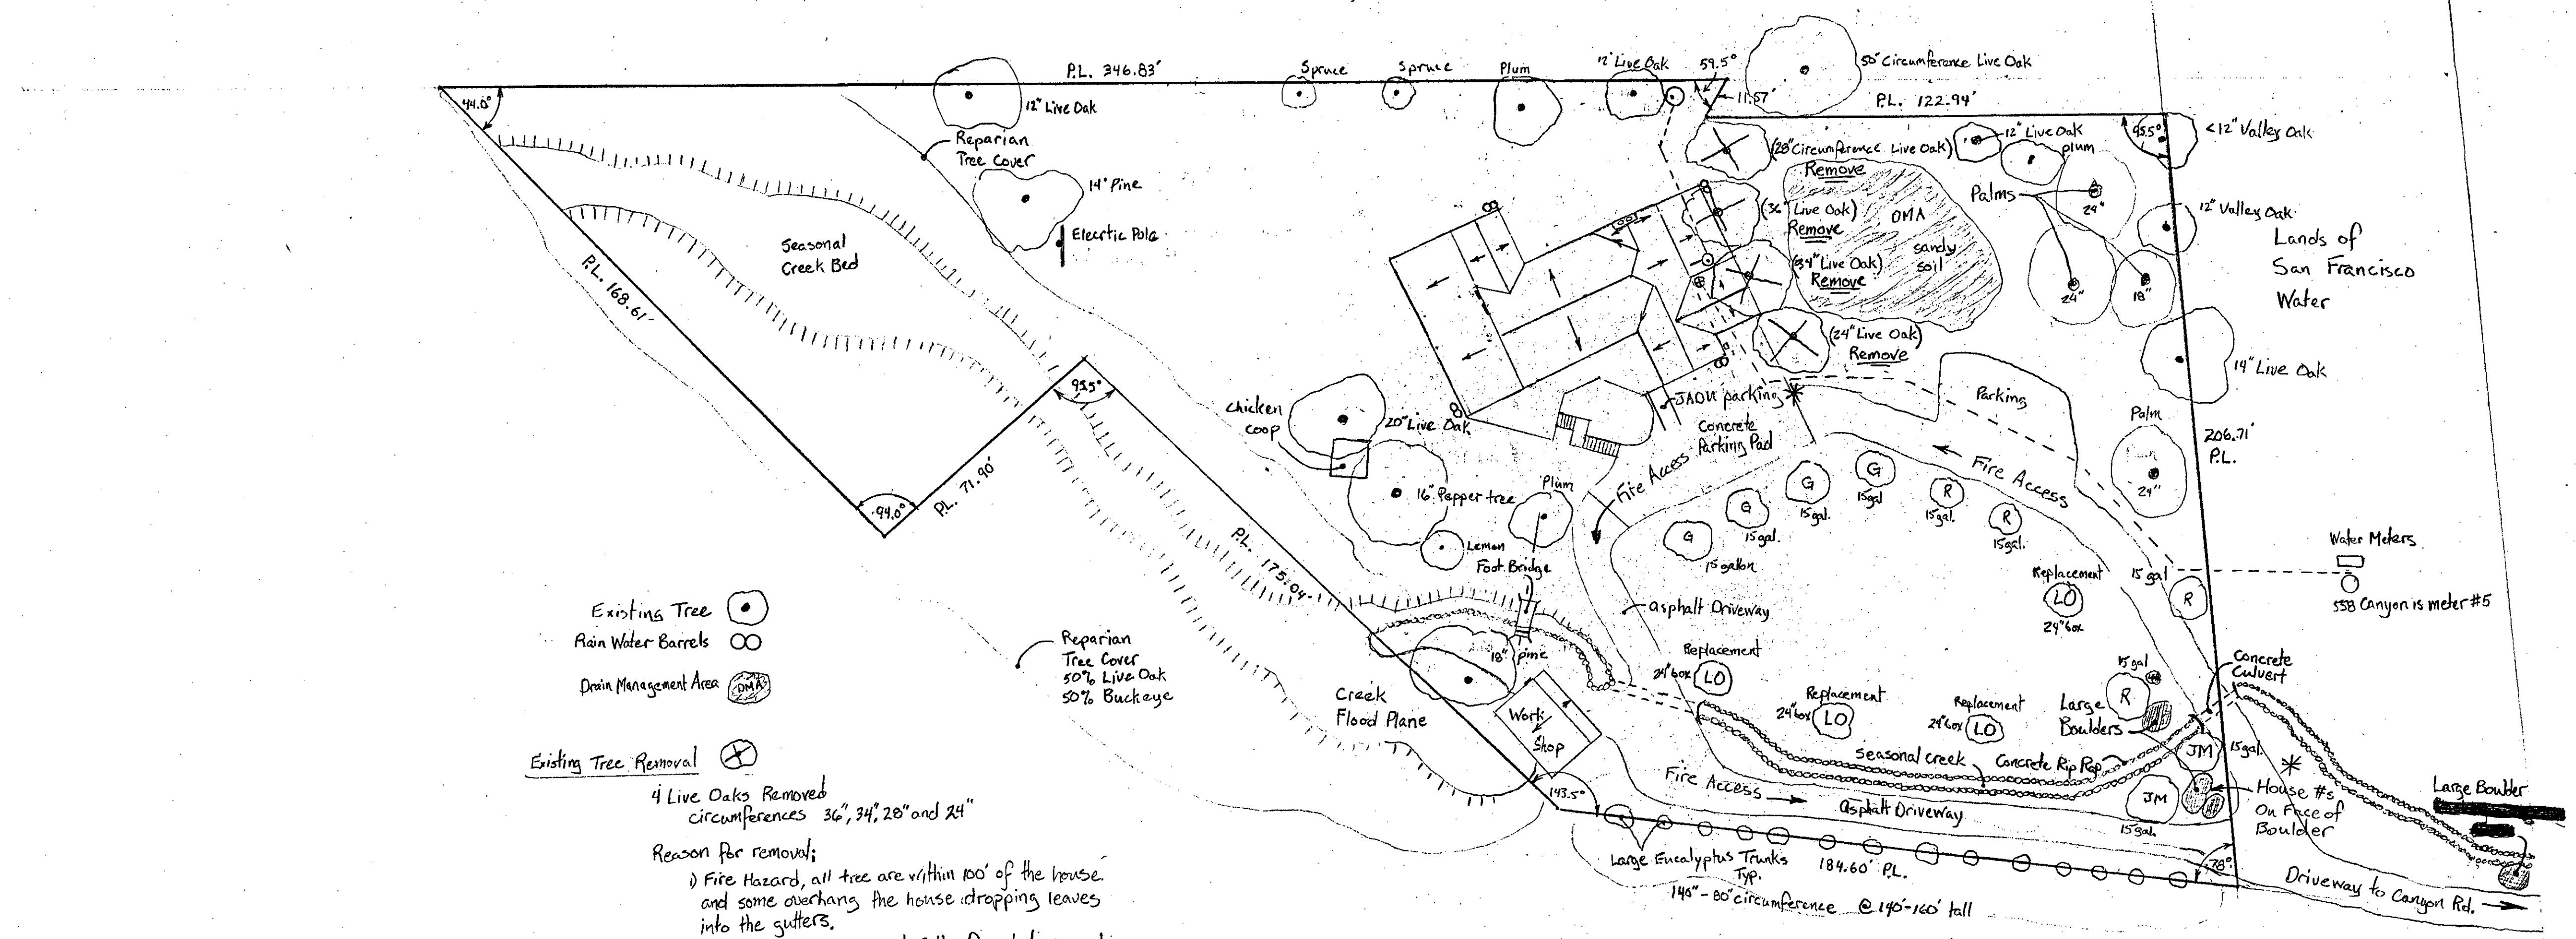

New Tree Planting (Atr.)

- LO - Live Oak x 4. 24" Box - Replacement trees
- G - Ginko x 4 15 gallon
- R - Western Red Bud x 4 15 gallon
- JM - Japanese Maple x 2 15 gallon

- 1) New trees to be planted in over sized holes at the beginning of winter while they are still dormant to take advantage of seasonal rainfall.
- 2) Dig the hole twice as wide and twice as deep and fill with amended soil to encourage root growth.
- 3) Amended soil should be a one to one mix of native soil and cured compost.
- 4) Mulch should be layered around base of newly planted tree to aid in water retention.
- 5) Watering will be done by hose as needed for the first year while the new tree sets roots; afterwards seasonal rainwater and water collected from the rain barrels will be used.

Irrigation

- 1) None planned except from rainwater barrels to new trees and drain management areas (DMA).
- 2) Since no turf is to be planted there will be no sprinkler system.
- 3) No drip systems for landscaping, since only drought tolerant native plants will be used. We have many deer that call our place home and they would just eat it anyway.

Water Features

- 1) We had planned a koi pond by the front entry bed changed our minds when confronted by the amount of water that would be needed to keep it full due to evaporation, so we decided on a rock and cactus garden instead.
- 2)

* Tree Protection

- 1) Since all trees have been removed that were close to the house for fire protection there aren't any that have their dripline anywhere close to any development.

* Fire Notes:

- Fire apparatus access road shall comply with the requirements of CFC 2022 Section 503
- It shall extend to within 150' of all portions of the house and all portions of exterior walls.
- They shall be designed and maintained to support loads of fire apparatus and shall be surfaced to provide for all-weather driving capabilities.
- The grade of the fire apparatus road shall be within limits established by fire code official based on the fire departments apparatus. Grading must comply with San Mateo County fire standard detail CFS-004
- Where buildings are located remotely to the public roadway, additional signage at the driveway/roadway entrance leading to the building is required. This remote signage shall consist of a 6' x 18' green reflective metal sign with 4" reflective numbers and letters similar to Hy-Ko 911 or equivalent.
- Weeds, grass, vines or other growth that is capable of being ignited and endangering property, shall be cut down and removed by owner.
- Vegetation clearance requirements in wildland-urban interface areas shall be in accordance with Chapter 49.
 - Defensible space will be managed around all buildings and structures in State Responsibility Areas (SRA) as required in Public Resources Code 4291
- Gates shall be a minimum of 2 feet wider than the roadway they serve. Overhead gate structures shall have a minimum of 15.5 feet vertical clearance. Locked gates shall be provided with a Knox Box or Knox Padlock for fire department access. Electric gates shall be provided with a Knox Gate Switch and automatically open during power failures, unless equipped with manual override capability that is approved by San Mateo County Fire Department.

558 Canyon Rd. Emerald Hills 94062
Owners: David and Jan Saunders

2220 Mora Glen Dr. Los Altos Hills CA 94022

Contact: Calum Lucero 408-242-8202 / squald198@gmail.com

Date 5/10/2023
Scale 1mm = 1 foot
Drawn CBL
Job 558 Canyon Rd
Sheet 7
of 10 Sheets

SURVEYOR'S STATEMENT

THIS MAP CORRECTLY REPRESENTS A SURVEY MADE BY ME OR UNDER MY DIRECTION IN CONFORMANCE WITH THE REQUIREMENTS OF THE LAND SURVEYORS ACT. THE BOUNDARY LINES SHOWN ON BASED ON A BOUNDARY SURVEY DONE BY WILSON LAND SURVEYS INC.

Kenneth D. Wilson 7/25/2023

KENNETH D. WILSON LS 5571 DATE

BENCHMARK

ELEVATIONS FOR THIS SURVEY ARE BASED ON ASSUMED ELEVATION OF 500.00' AT CONTROL POINT #1.

GENERAL NOTES

1. TREE SIZES AND TYPES ARE APPROXIMATE AND SHOULD BE VERIFIED BY A CERTIFIED ARBORIST.
2. FINISH FLOOR ELEVATIONS ARE TAKEN AT DOOR THRESHOLDS.
3. BUILDING CORNERS WERE LOCATED AT FINISH LOCATIONS (STUCCO, BLOCK OR WOOD AS IT EXISTS IN THE FIELD).

UNDERGROUND UTILITY NOTE

UNDERGROUND UTILITY LINES, IF SHOWN, DEPICT THE ESTIMATION OF WHERE THE ACTUAL LINES MAY BE LOCATED. THE LINES WERE DETERMINED BY CONNECTING VISIBLE UTILITY APPURTENANCES AND ALSO BY USING PAINTED MARKINGS PLACED BY OTHERS. THE UNDERGROUND UTILITIES MAY OR MAY NOT BE AS DEPICTED ON THIS SURVEY. NO WARRANTY IS ACCEPTED FOR ANY DISCREPANCIES, OMISSIONS OR ERRORS WITH REGARD TO SAD UNDERGROUND UTILITY DEPICTIONS ON THIS SURVEY.

IF NO INDICATION OF SEWER LINES ARE SHOWN, THEN THERE WERE NO VISIBLE MARKINGS OR INDICATIONS OF ANY SEWER APPURTENANCES ON THE SITE. OTHER RECORDS MAY EXIST THAT PROVIDE EVIDENCE OF SEWER LATERAL LOCATIONS.

SETBACK LINES NOTE

BUILDING SETBACK LINES WERE NOT SHOWN ON THIS MAP (EVEN IF THEY ARE SHOWN ON THE ORIGINAL TRACT MAP). THE DESIGNER SHOULD CHECK WITH THE APPROPRIATE AUTHORITY TO DETERMINE BUILDING SETBACK LINES.


TITLE REPORT NOTE

A CURRENT TITLE REPORT WAS NOT AVAILABLE AT THE TIME OF THIS SURVEY. EASEMENTS MAY EXIST ON THIS PROPERTY WHICH ARE NOT SHOWN. A CURRENT TITLE REPORT IS REQUIRED IN ORDER TO DETERMINE THE EXISTENCE OF ANY EASEMENTS OF RECORD. THE BOUNDARY WAS DETERMINED FROM THE CURRENT VESTING DEED.

LEGEND

- FOUND AS NOTED
- JP JOINT POLE
- EM ELECTRIC METER
- OL OVERHEAD LINE
- SM SEWER MANHOLE
- CP CONTROL POINT
- FENCE
- CONCRETE
- PROPERTY LINE
- S.S.E. SANITARY SEWER EASEMENT
- BUILDING
- FF FINISH FLOOR ELEVATION

Email: kenw@wilsonlandsurveys.com
www.wilsonlandsurveys.com

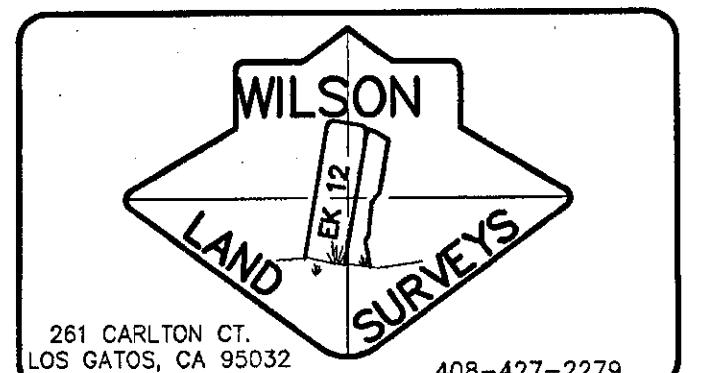

BOUNDARY AND TOPOGRAPHIC SURVEY

AS REQUESTED BY:
SCOTT LUCERO

LEGAL DESCRIPTION: PARCEL 3, 62 MAPS 44, COUNTY OF SAN MATEO, STATE OF CALIFORNIA


APN: 057-201-150

DATE: JULY 2023


FILENAME: P-104 CANYON LUCERO TOPO

SITE ADDRESS: 558 CANYON RD. EMERALD HILLS, CA 94062

DRAWN BY: CER SCALE: 1"=20' PROJECT: P-104 JOB NUMBER: P-104 SHEET: 1 OF 1

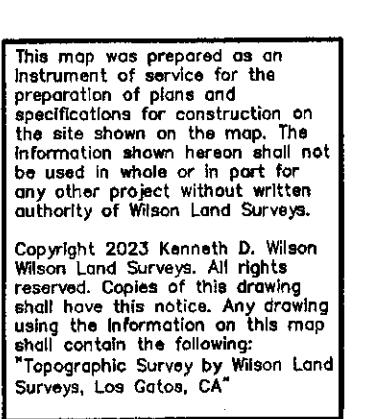

LICENSED LAND SURVEYOR
 KENNETH DOUGLAS WILSON
 NO. 5571
 7/25/2023
 STATE OF CALIFORNIA

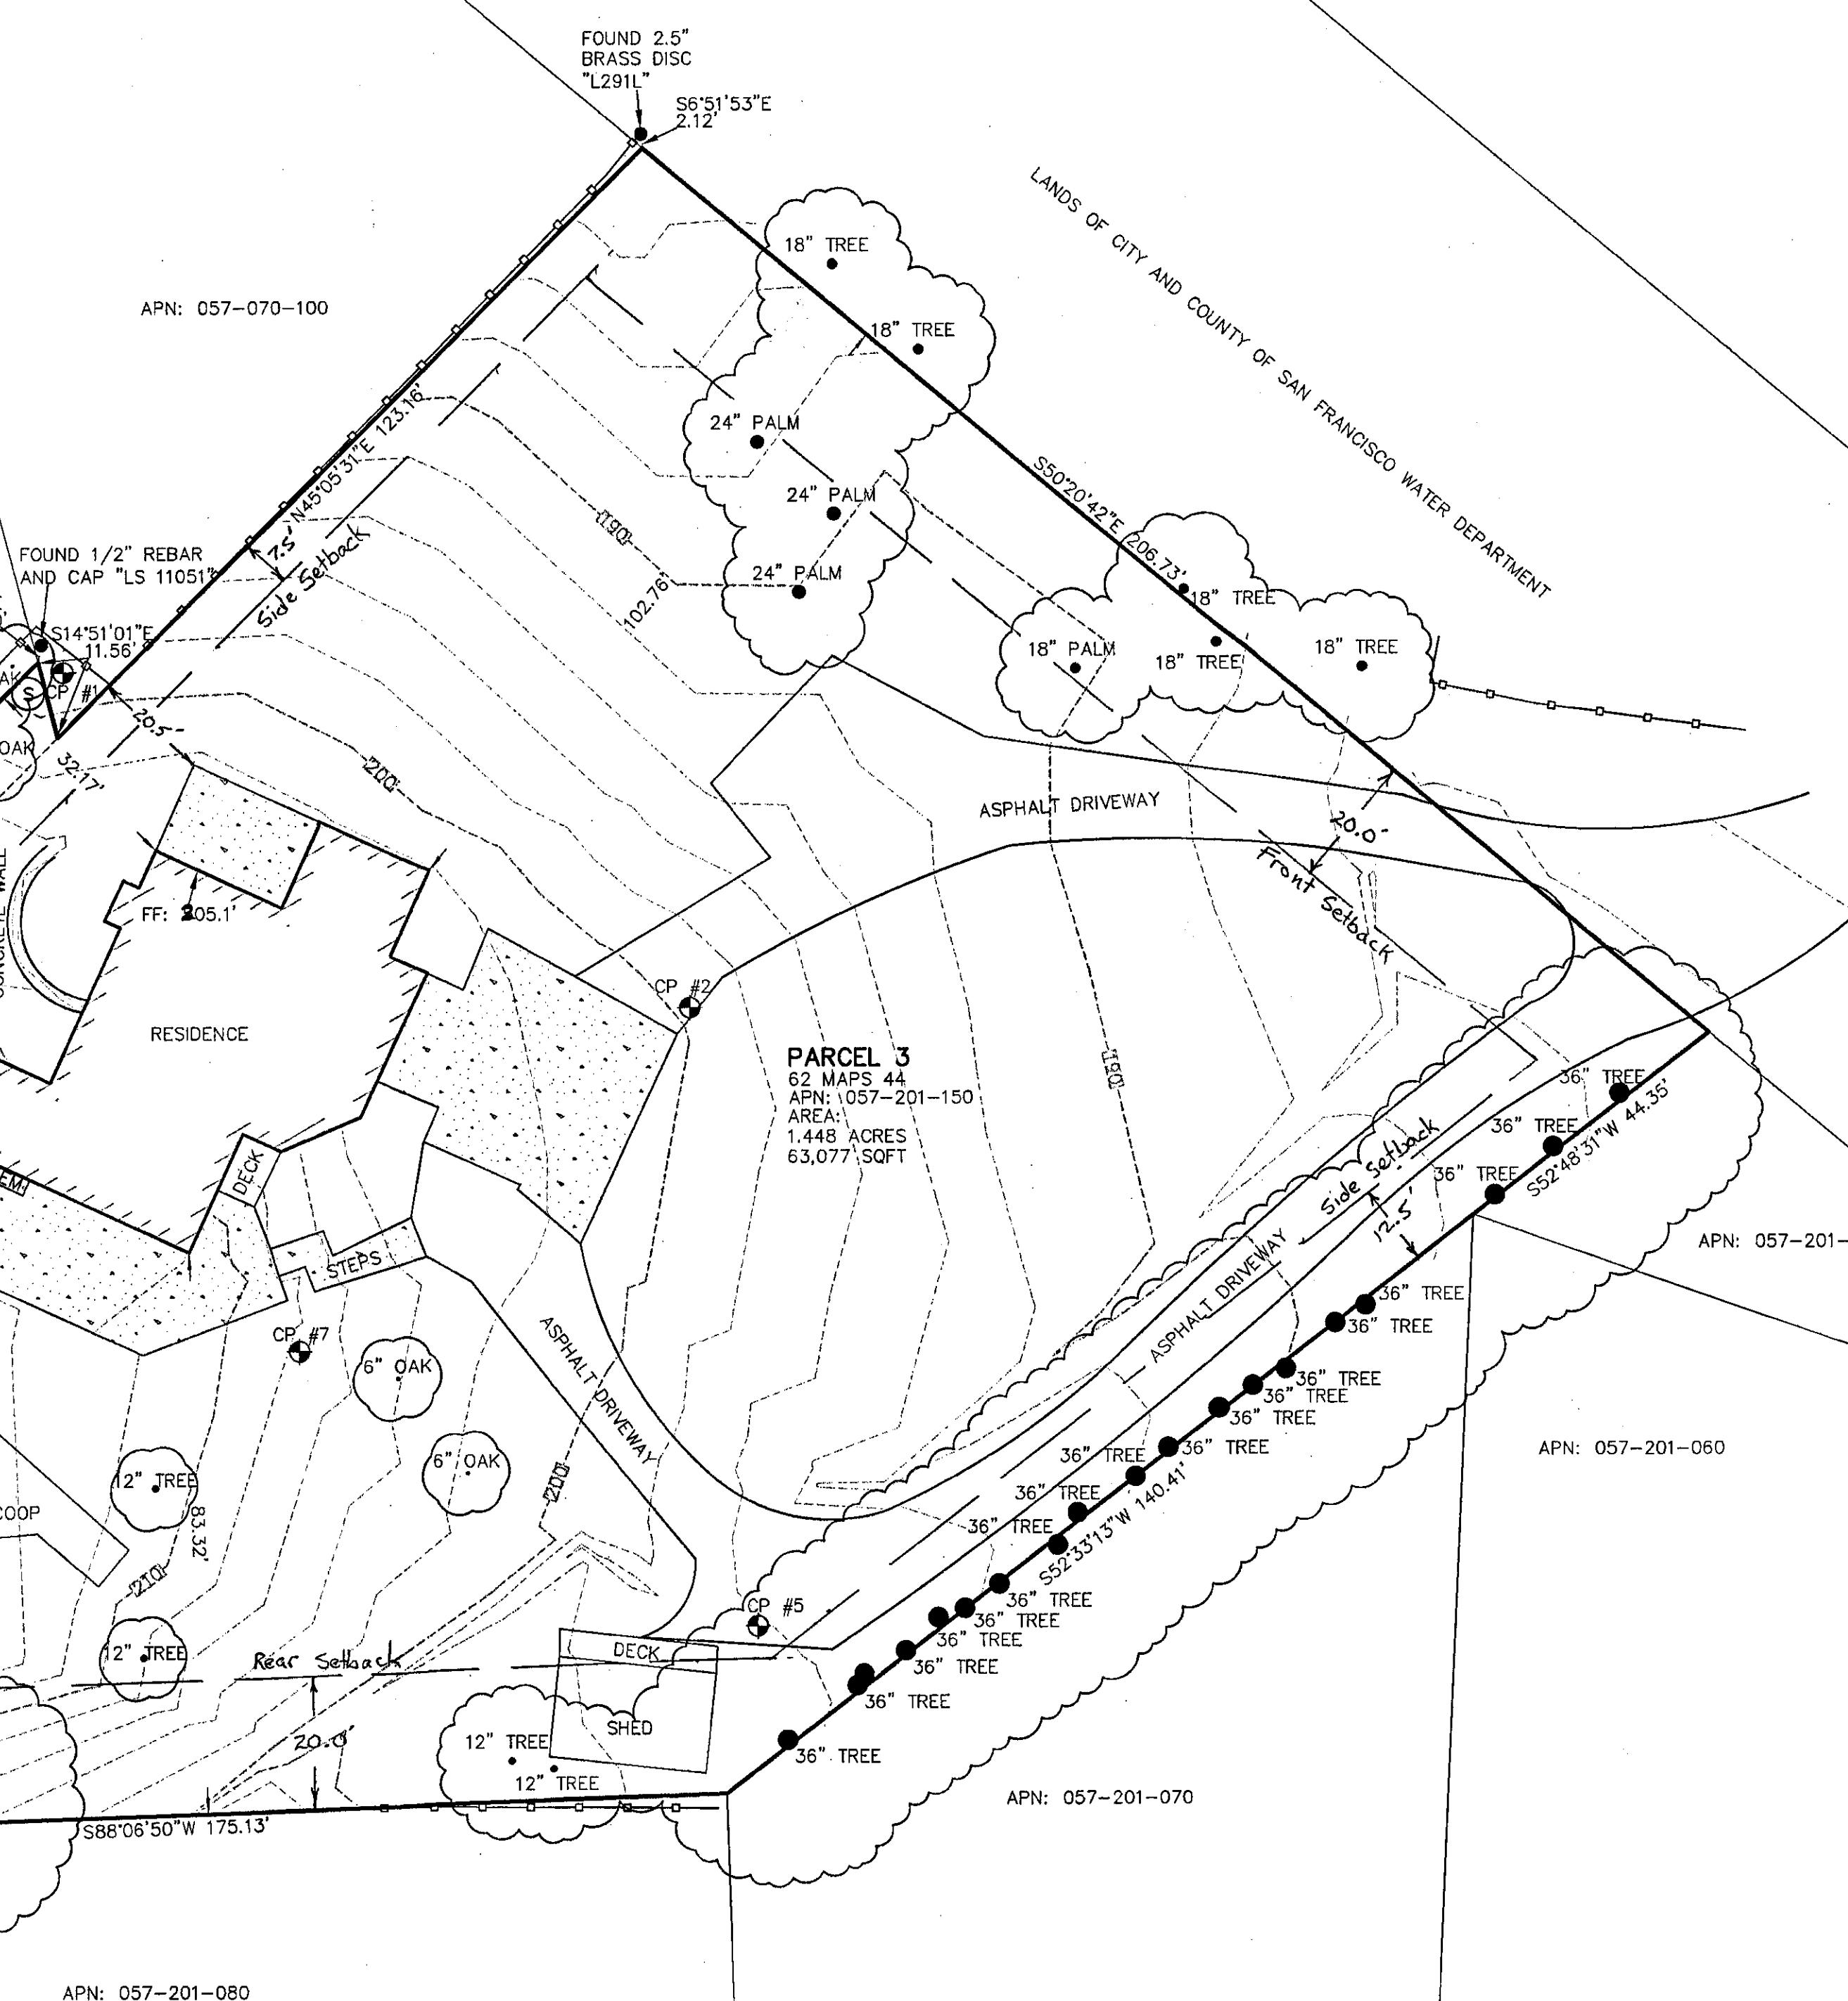

PARCEL 2
62 MAPS 44
APN: 057-201-140

PARCEL 1
62 MAPS 44
APN: 057-201-130

This map was prepared as an instrument of service for the preparation of plans and specifications for construction on the site shown on the map. The map and its contents shall not be used in whole or in part for any other project without written consent of the surveyor.

Copyright 2023 Kenneth D. Wilson Land Survey. All rights reserved. Copies of this drawing shall not be reproduced without the express written consent of the surveyor.

Topographic Survey by Wilson Land Survey, Los Gatos, CA*

Storm Water Controls Impervious Surfaces
Storm Flow Tenant Parking

- DMA Drainage Management Area
- 55 gallon rain water catchment tanks (2)
- Rain gutter down spout
- New or replaced impervious surface
- Rain water drainage direction

Pre-project impervious surface
Existing to be retained
New or replaced

7100 sqft.
7100 sqft.
2321 sqft.
Total 9421 sqft.

Excavation and Grading Plan

- ① Excavate soil to subgrade and dig footings for Bedroom #1 Extension. Subgrade must be $>18''$ below floor joists and frostings for the foundation must be $12'' \times 12''$ below subgrade. Excavated soil to be moved to ②.
- ② Spread soil from ① evenly throughout area filling in uneven spots to a depth of $\pm 4''$. Once spread cover with 6" of mulch.
- ③ Excavate soil to lower subgrade 6" for Northside Concrete Patio and Covered Second Story Deck. Dig $18'' \times 16''$ footings below subgrade. Move excavated soil to ⑥.
- ④ Excavate $4' \times 5' \times 16''$ of soil to straighten retaining wall and deepen existing footings for South Side Covered Concrete Patio. Move excavated soil to ⑥.
- ⑤ Excavate soil for $12'' \times 12''$ footings to follow existing grade for Wood Framed Entry Platform. Mail soil to ⑥.
- ⑥ Existing raised pad has too much slope/use soil to bring pad level equal to entry point from driveway.
- ⑦ No soil was moved for Concrete Entry Platform and Stairs. The forms are to follow grade.

Move 4.5 yards
Move 7.8 yards
Move 8.9 yards
Move 1.1 yards

Total Moved 21.3 yards
Total Imported 0 yards
Total Exported 0 yards

